

London Borough of Waltham Forest
73 Kings Road, Leytonstone

Utility Services Report
for
73 Kings Road, Leytonstone



MLM.

Group

Part of Sweco

Notice

This document and its contents have been prepared and intended solely for London Borough of Waltham Forest's information and use in relation to 73 Kings Road, Leytonstone.

MLM Consulting Engineers Limited assumes no responsibility to any other party in respect of or arising out of or in connection with this document and/or its contents.

Document History

Client: London Borough of Waltham Forest
Project: 73 Kings Road, Leytonstone Utility
Document Title: Services Report
Document Reference: 7152120-MLM-ZZ-XX-RP-U-0001
MLM Reference: BEB/7152120/ZW

Revision	Status	Description	Author	Checked/Approved	Date
00	-	For Information	Zoe Wood	Bawden Burrows	08/11/2019

Contents

1	Introduction	1
2	General Description of Works	2
3	Existing Utility Supply Company Contact List	3
3.1	Gas.....	3
3.2	Water.....	3
3.3	Electricity	3
3.4	British Telecommunications	3
4	General Description of Existing Services	4
4.1	Introduction	4
4.2	Gas Service	4
4.3	Water.....	5
4.4	Sewer	5
4.5	Electricity	5
4.6	Telecommunications	6
4.7	Other Underground Services.....	7
5	Diversion of Existing Services.....	2
5.1	Gas.....	2
5.2	Water.....	2
5.3	Sewer.....	2
5.4	Electricity	2
5.5	Telecommunications	2

Appendix A - Site Plan

Appendix B - Information Received

B1	Gas
B2	Water
B3	Sewer
B4	Electricity
B5	BT
B6	Virgin Media

1 Introduction

This report is based upon information received from Utility Services Supply Companies and is, therefore deemed a desktop study. The information contained therein is therefore suitable for pre-planning purposes only

Construction works should not be carried out until accurate below ground surveys are completed by a Specialist Contractor. This may identify additional services not contained in this report and alter the scope of the proposed works. Excavation works close to below ground services shall be carried out by hand and the Contractor shall ensure that all works to and close to below ground and utility services are planned, managed and executed in accordance with the requirements of the CDM Regulations. Isolation of utility services shall be by authorised persons only. The Contractor shall also refer to 'Avoiding Danger from Underground Services' published by the HSE, Reference HS(G)47, ISBN 0118854925.

2 General Description of Works

This report details the existing utility services present within the boundary of, and in the locality of the development at 73 Kings Road, Leytonstone.

The proposed use of the site is currently unclear therefore this report focuses only on what is currently present in the area.

The information obtained in relation to the site is considered correct at the time of issue of the report. Should the preliminary proposals for the site vary, the Utility Services report should be reviewed, and if necessary utility suppliers re-approached to ascertain whether the advice received still applies or whether updated information should be obtained.

3 Existing Utility Supply Company Contact List

3.1 Gas

For Mapping Information: Cadent Gas, Brick Kiln Street, Hinckley, Leicester, LE10 0NA, T: 0800 074 5788

For New Supply: Cadent Gas, Brick Kiln Street, Hinckley, Leicester, LE10 0NA, T: 0800 074 5788

3.2 Water

Developer Services: Thames Water, Clearwater Court, Vastern Road, Reading, RG1 8DB, T: 0800 316 9800

Waste: Thames Water, Clearwater Court, Vastern Road, Reading, RG1 8DB, T: 0800 316 9800

Water By Laws: Water Regulations Technical Helpdesk, Rose Kiln Court, Rose Kiln Lane, Reading, Berkshire, RG2 0HP

3.3 Electricity

For Mapping Information: UK Power Networks (Operations) Limited, Newington House, 237 Southwark Bridge Road, London, SE1 6NP

New Supply/Diversion: EDF Energy, Networks Branch Connections, Projects Gateway, Metropolitan House, Darkes Lane, Potters Bar, Hertfordshire, EN6 1AG, T: 087014 964 599, E: connections.projectsgateway@edfenergy.com

3.4 British Telecommunications

For Mapping Information: via website only: www.btwholesale.com/btplant

New Supply/New Ductwork Entry Systems: British Telecommunications Plc, T: 0800 800150

Dial Before You Dig: T: 0800 917 3993, E: dbyd@bt.com

For New Supplies: Openreach Newsite, Aquarius Building, Adastral Park, Ipswich, IP5 3RE, T: 0800 592389

4 General Description of Existing Services

4.1 Introduction

MLM have been asked to produce a desktop study for the current utility services on around the site known as 73 Kings Road, Leytonstone.

The site is currently being used as an ambulance park for St Johns Ambulance.



The site from Kings Road



Mapping information provided by utility service providers does not normally include information regarding land ownership nor wayleaves/easements. For any works likely to be carried out close to utility services, the utility service provider should be notified before commencement.

4.2 Gas Service

Asset maps provided by Cadent Gas indicate there is a 180mm Polyethylene (PE) low pressure mains running along Kingswood Road to the south east of the site, this has 125mm PE branches into both Kings Road and Queens Road, these branches then split to run 90mm PE low pressure main parallel down both of the roads.



Gas services Queens Road



Gas services Kings Road

From the evidence provided there appears to be good gas services in the area.

4.3 Water

Maps provided by Thames Water show there are 4 inch supply mains running along Kings Road and Queens Road, surrounding the proposed site. There are two hydrants located along Kings Road, and three hydrants located down Queens Road. The mapping information is unclear as to the pipe material, we would assume it is some form of iron pipe but there is no indication to confirm this.



Hydrant on Kings Road



Hydrant on Queens Road

Maps indicate there are another hydrant located on the corner of Kings Road and Kingswood Road to the south of the site, along with three hydrants on the corner of Queens Road and Kingswood Road, however these were not seen during a site visit.

4.4 Sewer

Maps provided by Thames Water indicate foul sewer mains running along Kings Road and Queens Road, which serve the houses surrounding the site. The maps suggest these services run between Kings Road and Queens Road directly through the site area. Maps also show surface water mains running along both roads, which also connect directly through the site.

4.5 Electricity

Maps provided by UKPN show there are LV services in the area, along Queens Road and Kings Road. Within Kings Road the cables all run on the north side of the road, crossing to the south side of the street every so often to feed the properties on this side.

The maps suggest the only substations in the vicinity are located down Kings Passage to the north east of the site, and near Kirkdale Road, to the east of the site.

Subject to the requirements of the site it is likely that a small residential type load will be easily serviced but anything of a fairly significant load will require reasonable infrastructure upgrades. Given the location of the existing substations this could be relatively expensive, however the site in question is relatively small and unlikely that a large load requirement will be necessary.

4.6 Telecommunications

British Telecommunications

BT have provided maps which show they have a good services in the area. They have services running down Queens Road, Kings Road and Kingswood Road. There are BT poles and overhead cables located on Queens Road which appear to serve the buildings directly adjacent to the proposed site.



Overhead cables and BT poles located down Queens Road

There are also BT poles and overhead cables located along Kings Road which serve the building adjacent to the site. There is a BT box located down Kings Road opposite the proposed site.



BT box opposite site on Kings Road



BT poles and overhead cables located along Kings Road



Maps indicate there is a BT cabinet located along Kingswood Road, between Kings Road and Queens Road to the south east of the site.



BT cabinet located along Kingswood Road



Virgin Media

Maps provided by Virgin Media indicate they have a good service in the area. There are services running along Queens Road and Kings Road, along with services along Kingswood Road. The Virgin services run on both sides of the street.



Virgin Media cabinet located on corner of Queens Road and Kingswood Road.

From the evidence provided from BT and Virgin Media, there appears to be good telecommunications services within the area.

4.7 Other Underground Services

The following organisations have reported, without prejudice, no services in the vicinity of the site which will be affected by the works, (refer to note on page 1 of this report).

- AWE Pipeline
- BP Exploration Operating Company Limited
- CATS Pipeline c/o Wood Group PSN
- CLH Pipeline System Ltd
- ConocoPhillips (UK) Ltd
- E.ON UK CHP Limited
- ENI & Himor c/o Penspen Ltd

- ESP Utilities Group
- Fulcrum Pipelines Limited
- Gigaclear Ltd
- Heathrow Airport LTD
- INEOS FPS Pipelines
- Intergen (Coryton Energy or Spalding Energy)
- Manx Cable Company
- Murphy Utility Assets
- Oikos Storage Limited
- Perenco UK Limited (Purbeck Southampton Pipeline)
- Premier Transmission Ltd (SNIP)
- RWE - Great Yarmouth Pipeline (Bacton to Great Yarmouth Power Station)
- Scottish and Southern Electricity Networks
- SES Water
- Shell (St Fergus to Mossmorran)
- SSE Enterprise Telecoms
- Total Finaline Pipelines
- Vattenfall
- Balfour Beatty Investments Limited
- BPA
- Cemex
- CNG Services Ltd
- DIO (MOD Abandoned Pipelines)
- EirGrid
- EnQuest NNS Limited
- ESSAR
- Gamma
- Gtt
- Humbly Grove Energy
- INEOS Manufacturing (Scotland and TSEP)
- Mainline Pipelines Limited
- Marchwood Power Ltd (Gas Pipeline)
- Northumbrian Water Group
- Ørsted
- Petroineos
- Prysmian Cables & Systems Ltd (c/o Western Link)
- RWEpower (Little Barford and South Haven)
- Scottish Power Generation
- Severn Trent (Chester area only)
- Shell Pipelines
- Tata Communications (c/o JSM Construction Ltd)
- Transmission Capital
- Veolia ES SELCHP Limited
- BOC Limited (A Member of the Linde Group)
- Carrington Gas Pipeline
- Centrica Storage Ltd
- Concept Solutions People Ltd
- Drax Group
- Electricity North West Limited
- EP Langage Limited
- Esso Petroleum Company Limited
- Gateshead Energy Company
- Hafren Dyfrdwy
- IGas Energy
- INOVYN Enterprises Limited
- Manchester Jetline Limited
- Melbourn Solar Limited
- NPower CHP Pipelines
- Perenco UK Limited (Purbeck Southampton Pipeline)
- Phillips 66
- Redundant Pipelines – LPDA
- SABIC UK Petrochemicals
- Seabank Power Ltd
- SGN
- SSE (Peterhead Power Station)
- Total (Colnbrook & Colwick Pipelines)
- Uniper UK Ltd
- Veolia ES Sheffield Ltd
- Wales and West Utilities
- Zayo Group UK Ltd c/o JSM Group Ltd
- Western Power Distribution
- Westminster City Council

5 Diversion of Existing Services

5.1 Gas

From the evidence provided, there appears to be no diversionary works necessary to the gas services in the area.

5.2 Water

From the evidence provided, there appears to be no diversionary works necessary to the water services in the area.

5.3 Sewer

From the evidence provided, there may be diversionary works necessary to the sewer services in the area, due to the services running directly through the site between Kings Road and Queens Road.

5.4 Electricity

From the evidence provided, there appears to be no diversionary works necessary to the electricity services in the area.

5.5 Telecommunications

From the evidence provided, there appears to be no diversionary works necessary to the telecommunications services in the area, however care should be taken when working close to BT poles and overhead cables in the vicinity of the site.

Appendix A - Site Plan






Water Main
Private Water
Proposed Water
Think Sign







Appendix B - Information Received


It should be noted that any information provided on the location of services in/around the proposed development should be used as guidance only and no excavation works should proceed without confirming these locations via scanning or hand dug trial holes in the first instance.

Information is provided as follows:

- B1 Gas
- B2 Water
- B3 Sewer
- B4 Electricity
- B5 BT
- B6 Virgin Media

B1 Gas

WARNING! This area contains Gas Mains Operating at Intermediate Pressure between 2 and 7 bar. Before excavating in the area call 0800 688588.

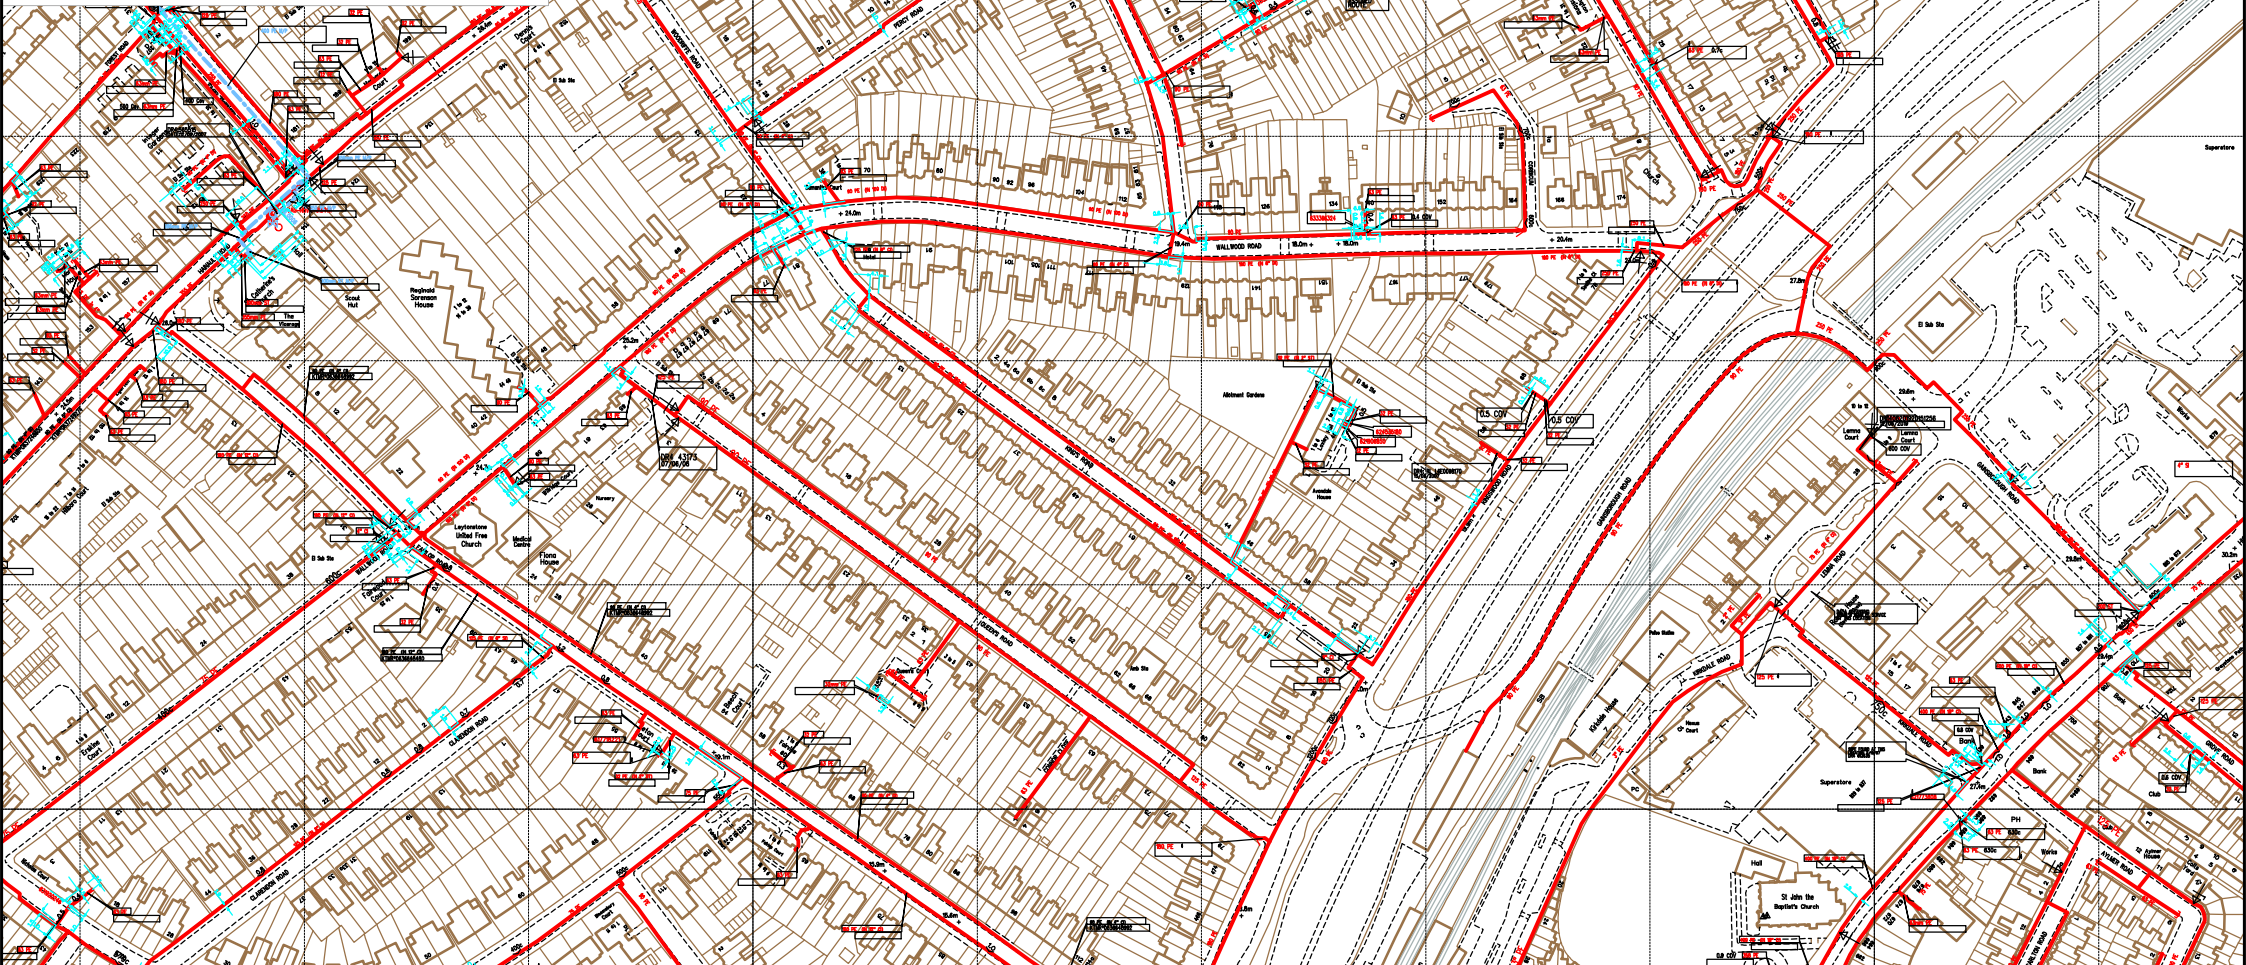

SCALE: Not to scale

USER ID: Luke

DATE: 23/10/2019

EXTRACT DATE: 10/06/2019

MAP REF: TQ3987

CENTRE: 539165, 187670

Some examples of Plant Items:



LP MAINS

MP MAINS

IP MAINS

LHP MAINS

This plan shows those pipes owned by Cadent Gas Ltd in their role as a Licensed Gas Transporter (GT). Gas pipes owned by other GTs, or otherwise privately owned, may be present in this area. Information with regard to such pipes should be obtained from the relevant owners. The information shown on this plan is given without warranty, the accuracy thereof cannot be guaranteed. Service pipes, valves, syphons, stub connections, etc. are not shown but their presence should be anticipated. No liability of any kind whatsoever is accepted by Cadent Gas Ltd or their agents, servants or contractors for any error or omission. Safe digging practices, in accordance with HS(G)47, must be used to verify and establish the actual position of mains, pipes, services and other apparatus on site before any mechanical plant is used. It is your responsibility to ensure that this information is provided to all persons (either direct labour or contractors) working for you on or near gas apparatus. The information included on this plan should not be referred to beyond a period of 28 days from the date of issue. Further information on all DR4s can be determined by calling the DR4 hotline on 01455 892426 (9am-5pm) A DR4 is where a potential error has been identified within the asset record and a process is currently underway to investigate and resolve the error as appropriate.

MAPS Viewer Version 5.8.0.1

Local Machine


This plan is reproduced from or based on the OS map by Cadent Gas Ltd, with the sanction of the controller of HM Stationery Office. Crown Copyright Reserved.

B2 Water



The position of the apparatus shown on this plan is given without obligation and warranty, and the accuracy cannot be guaranteed. Service pipes are not shown but their presence should be anticipated. No liability of any kind whatsoever is accepted by Thames Water for any error or omission. The actual position of mains and services must be verified and established on site before any works are undertaken.


Based on the Ordnance Survey Map with the Sanction of the controller of H.M. Stationery Office, License no. 100019345 Crown Copyright Reserved.

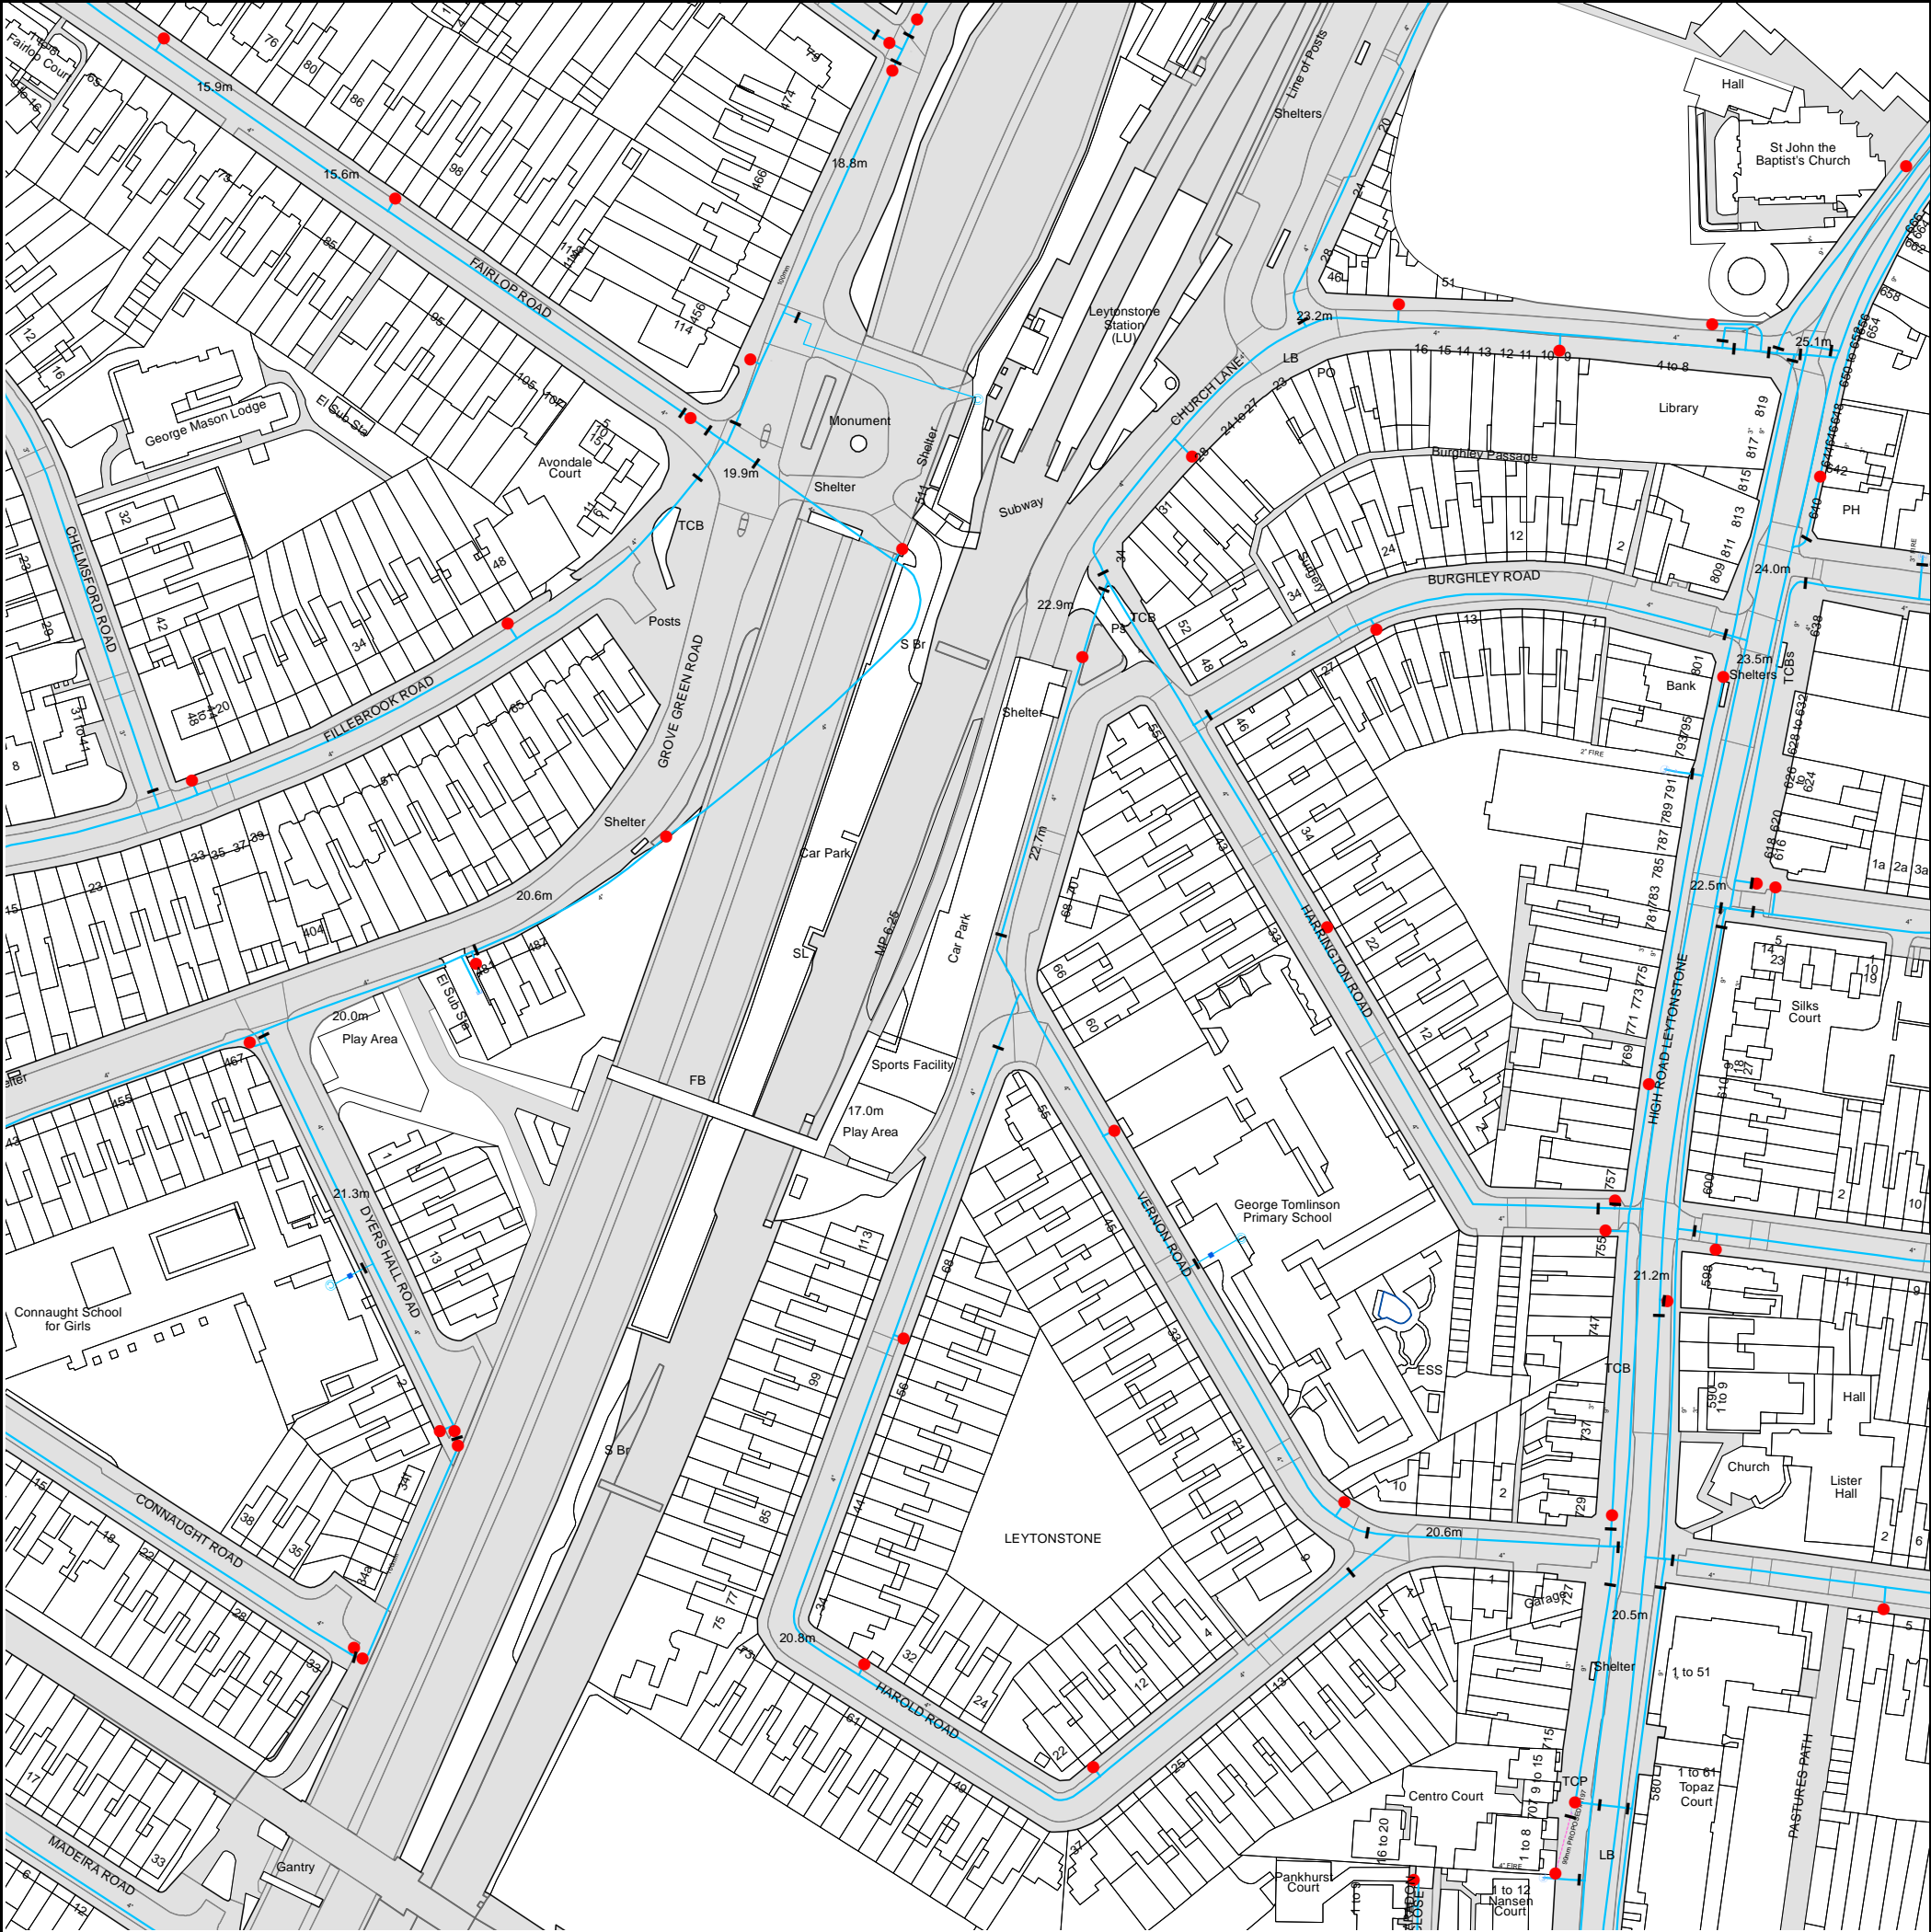

The width of the displayed area is 500m and the centre of the map is located at OS coordinates 539250,187250


The position of the apparatus shown on this plan is given without obligation and warranty, and the accuracy cannot be guaranteed. Service pipes are not shown but their presence should be anticipated. No liability of any kind whatsoever is accepted by Thames Water for any error or omission. The actual position of mains and services must be verified and established on site before any works are undertaken.

Based on the Ordnance Survey Map with the Sanction of the controller of H.M. Stationery Office, License no. 100019345 Crown Copyright Reserved.

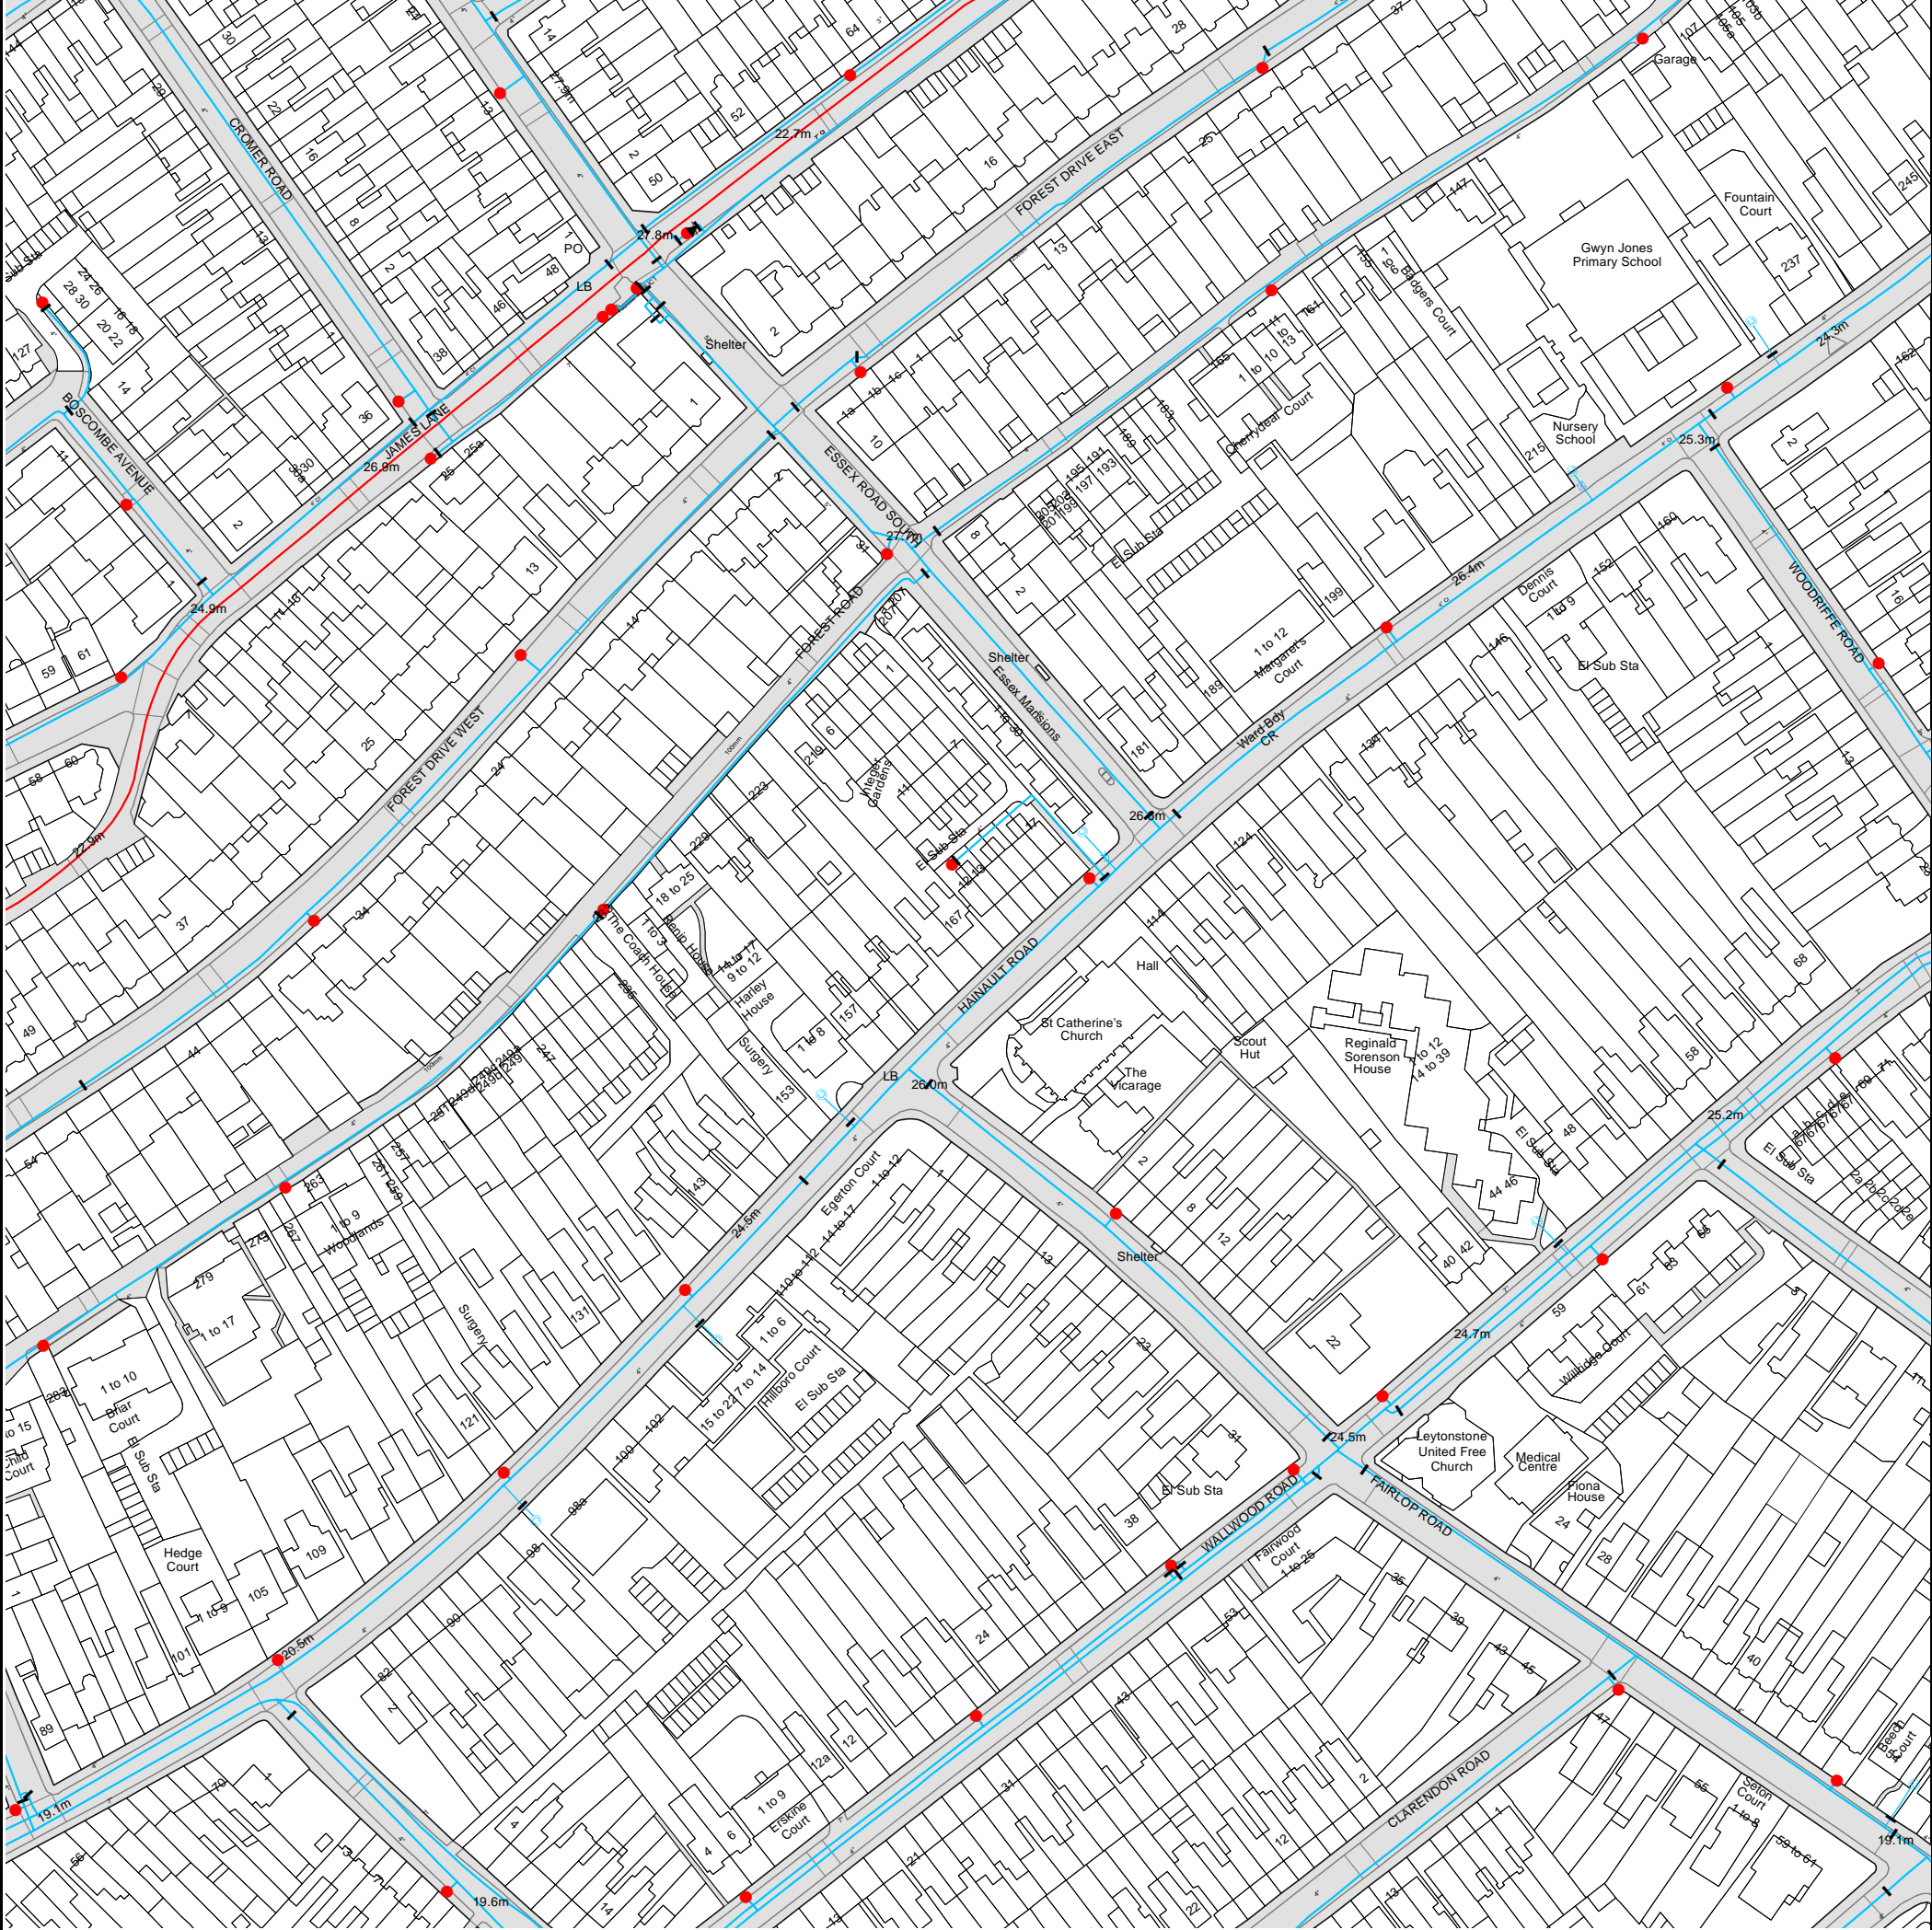

The width of the displayed area is 500m and the centre of the map is located at OS coordinates 538750,187750
The position of the apparatus shown on this plan is given without obligation and warranty, and the accuracy cannot be guaranteed. Service pipes are not shown but their presence should be anticipated. No liability of any kind whatsoever is accepted by Thames Water for any error or omission. The actual position of mains and services must be verified and established on site before any works are undertaken.


Based on the Ordnance Survey Map with the Sanction of the controller of H.M. Stationery Office, License no. 100019345 Crown Copyright Reserved.

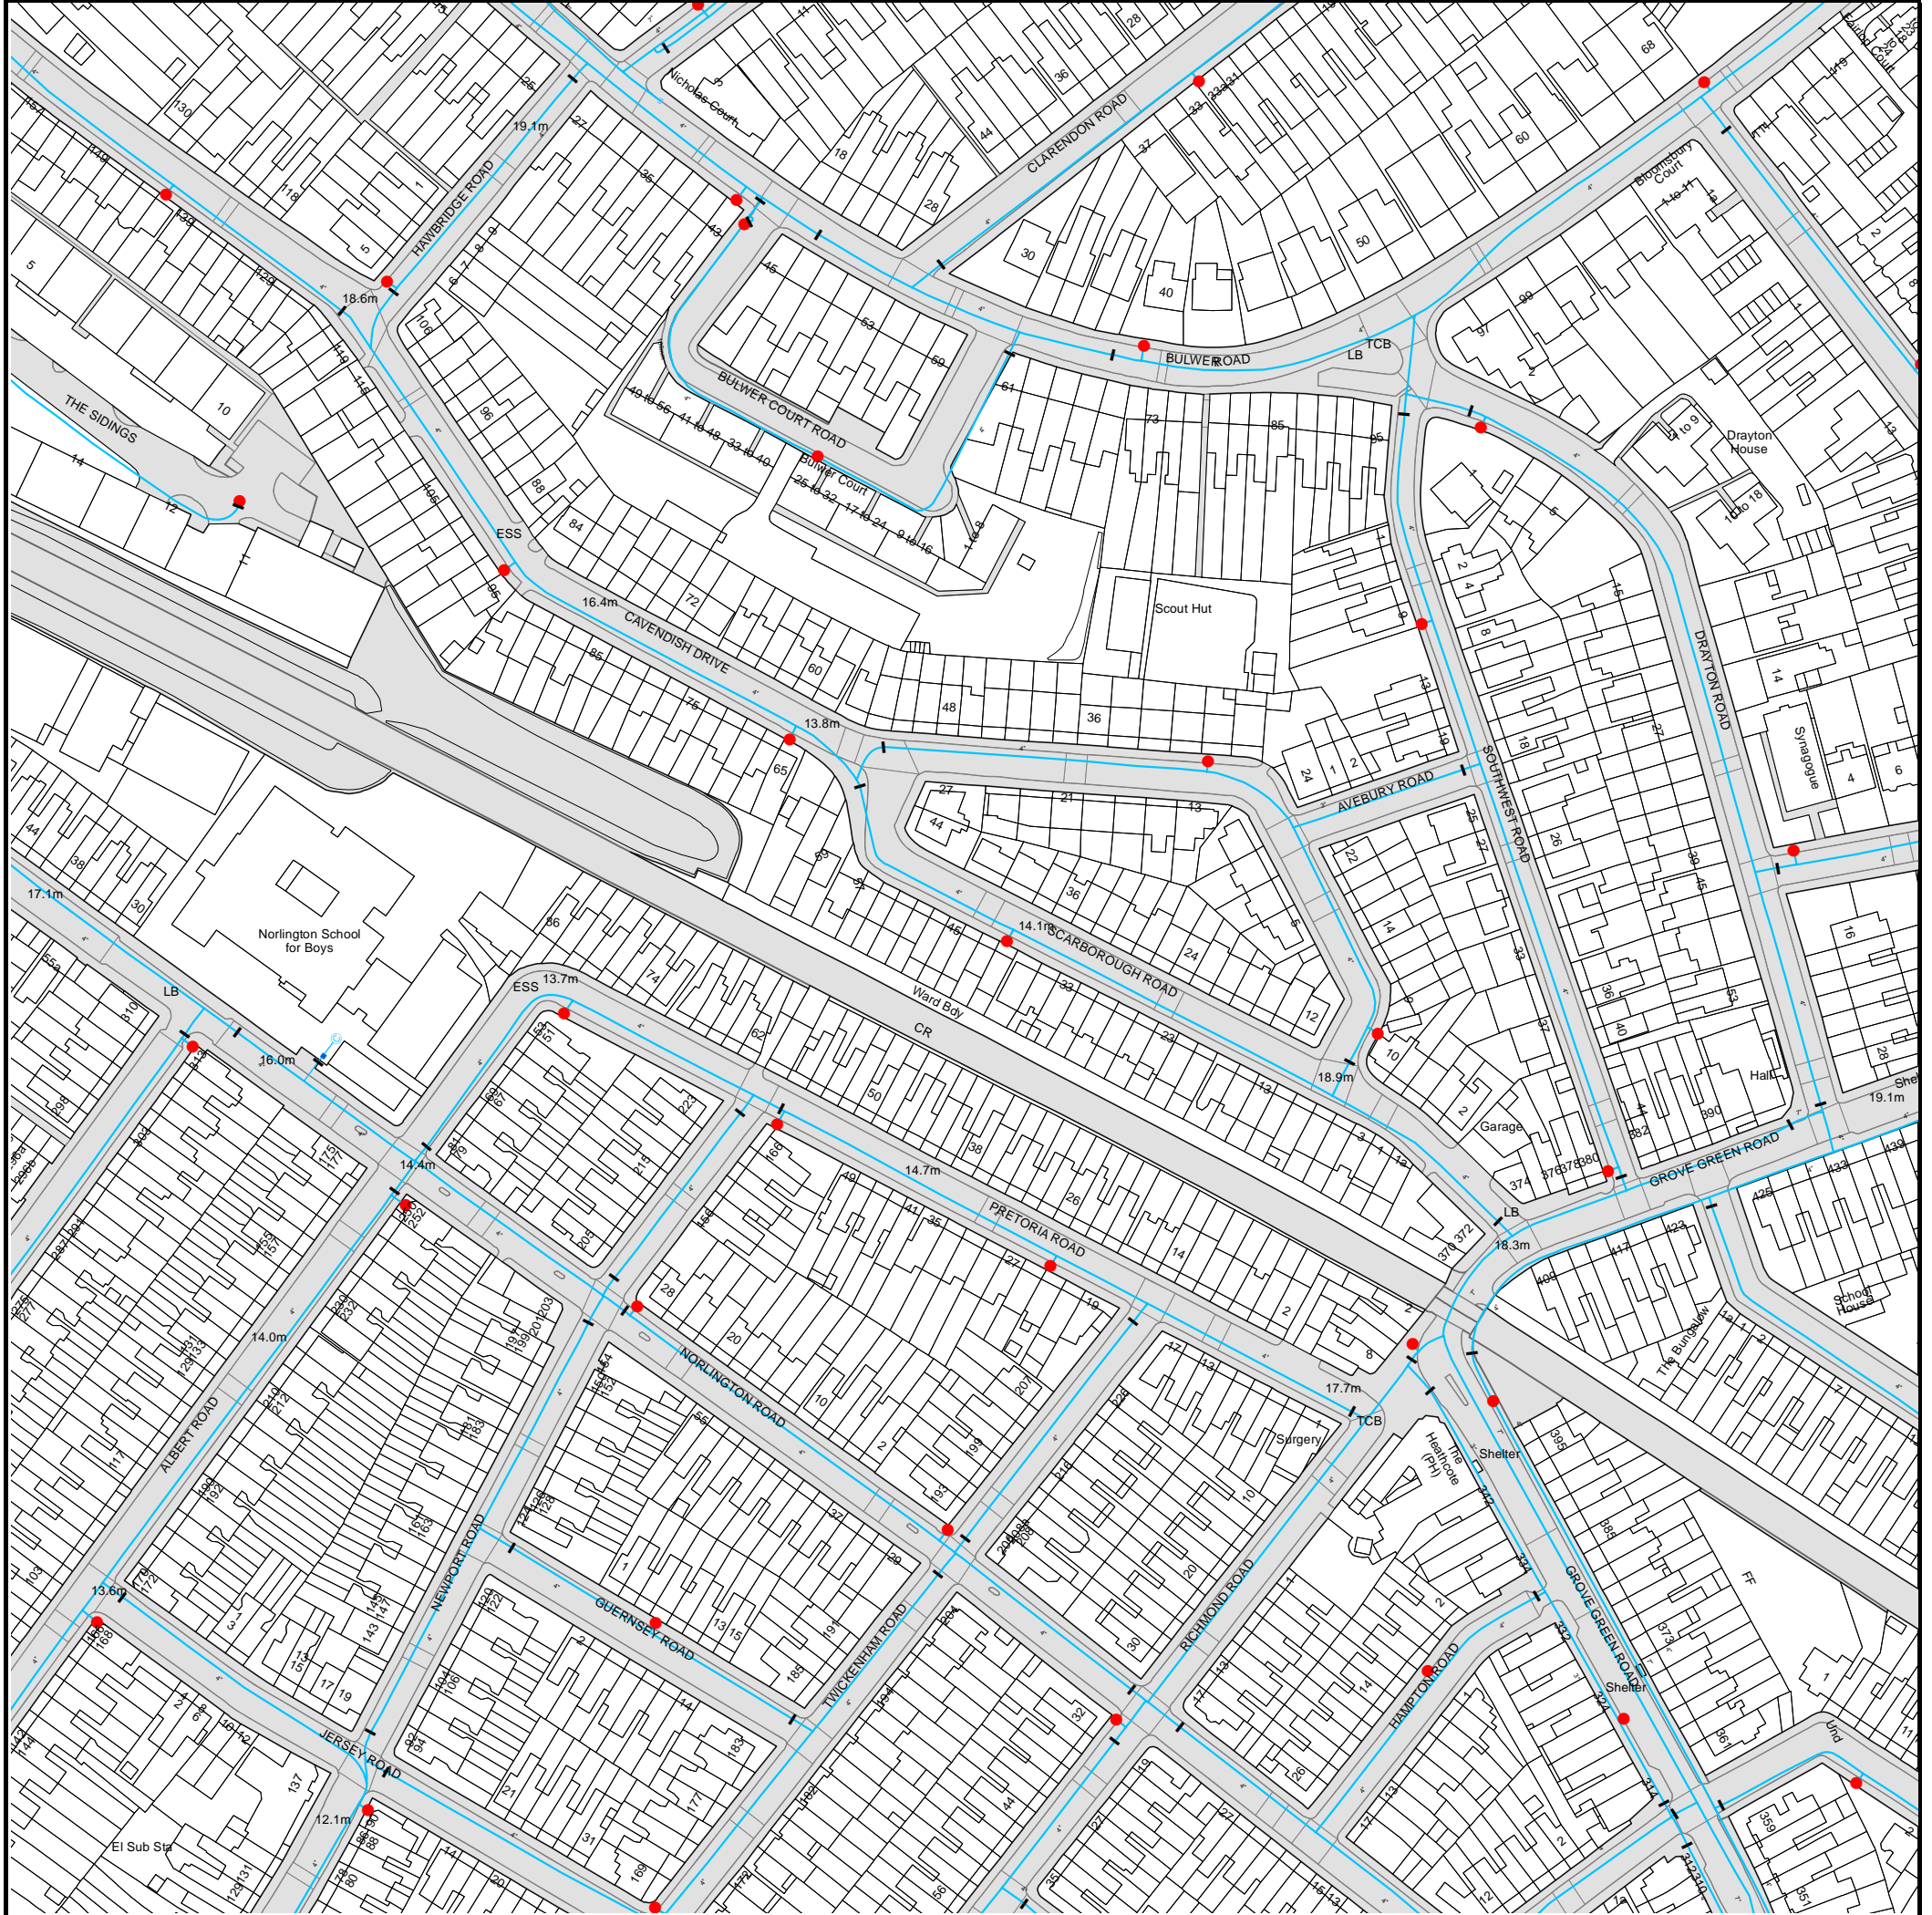

The position of the apparatus shown on this plan is given without obligation and warranty, and the accuracy cannot be guaranteed. Service pipes are not shown but their presence should be anticipated. No liability of any kind whatsoever is accepted by Thames Water for any error or omission. The actual position of mains and services must be verified and established on site before any works are undertaken.

Based on the Ordnance Survey Map with the Sanction of the controller of H.M. Stationery Office, License no. 100019345 Crown Copyright Reserved.


B3 Sewer

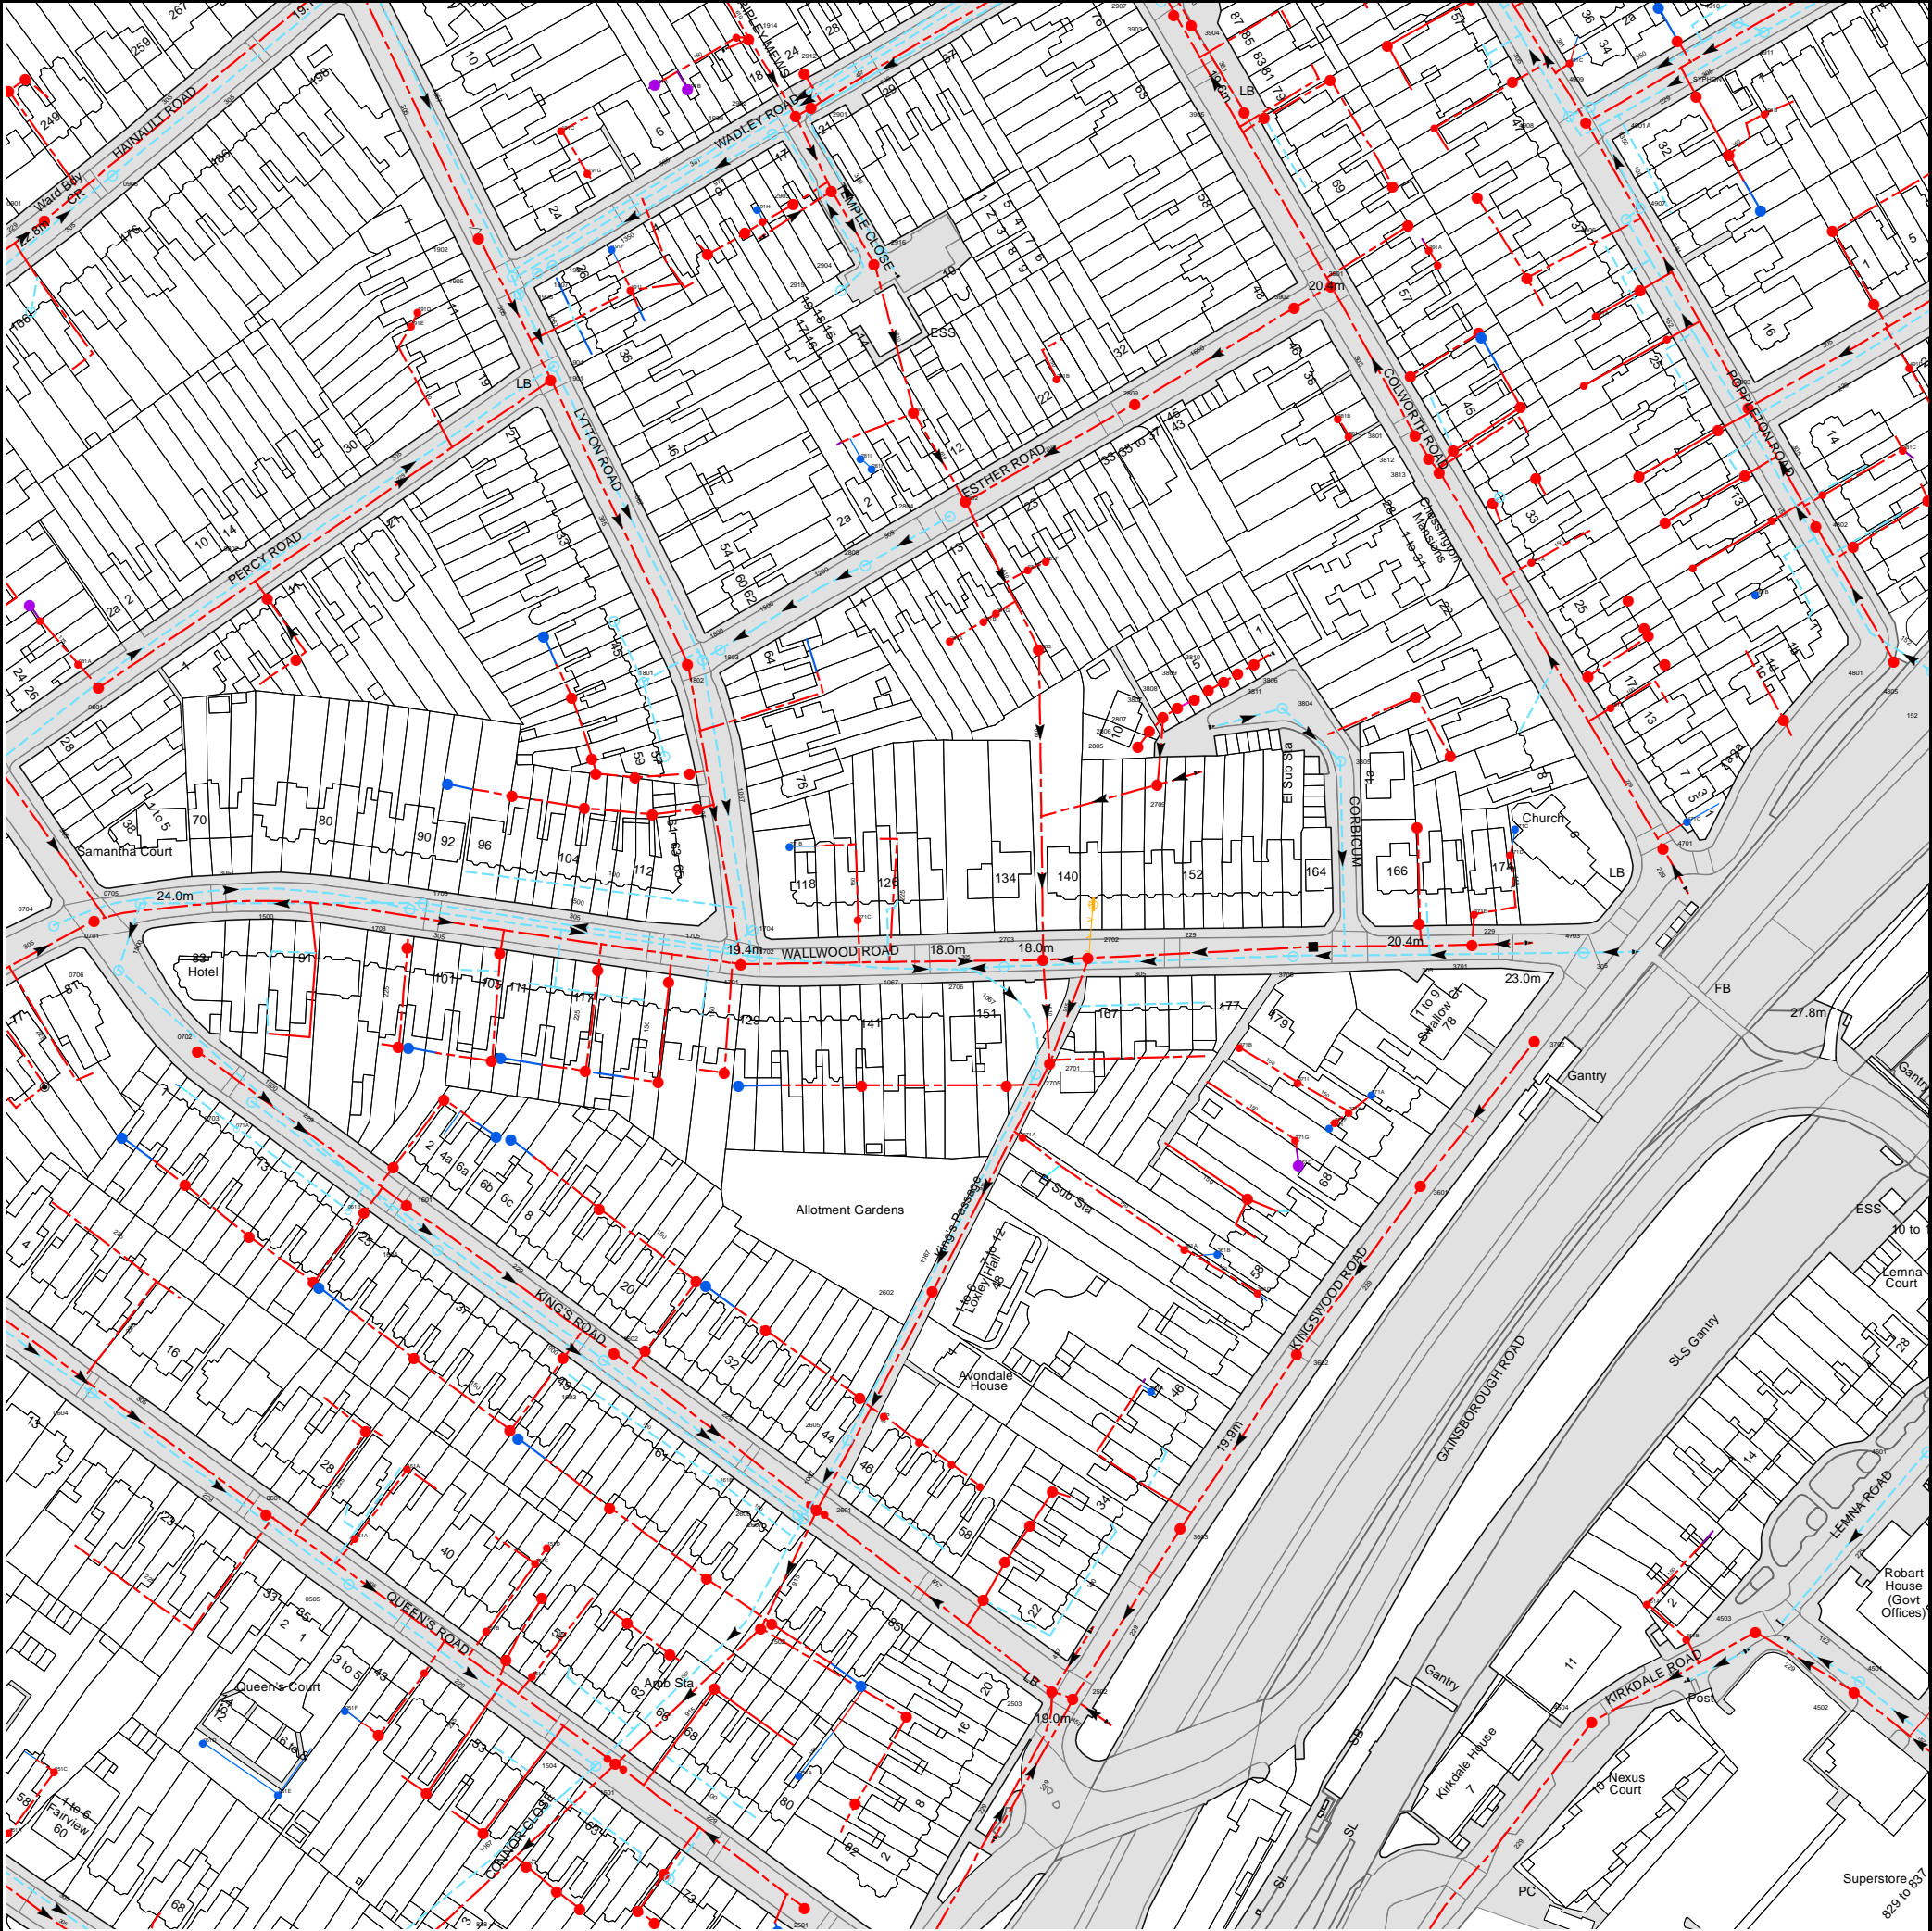

The width of the displayed area is 500m and the centre of the map is located at OS coordinates 539250,187750

The position of the apparatus shown on this plan is given without obligation and warranty, and the accuracy cannot be guaranteed. Service pipes are not shown but their presence should be anticipated. No liability of any kind whatsoever is accepted by Thames Water for any error or omission. The actual position of mains and services must be verified and established on site before any works are undertaken.

Based on the Ordnance Survey Map with the Sanction of the controller of H.M. Stationery Office, License no. 100019345 Crown Copyright Reserved.

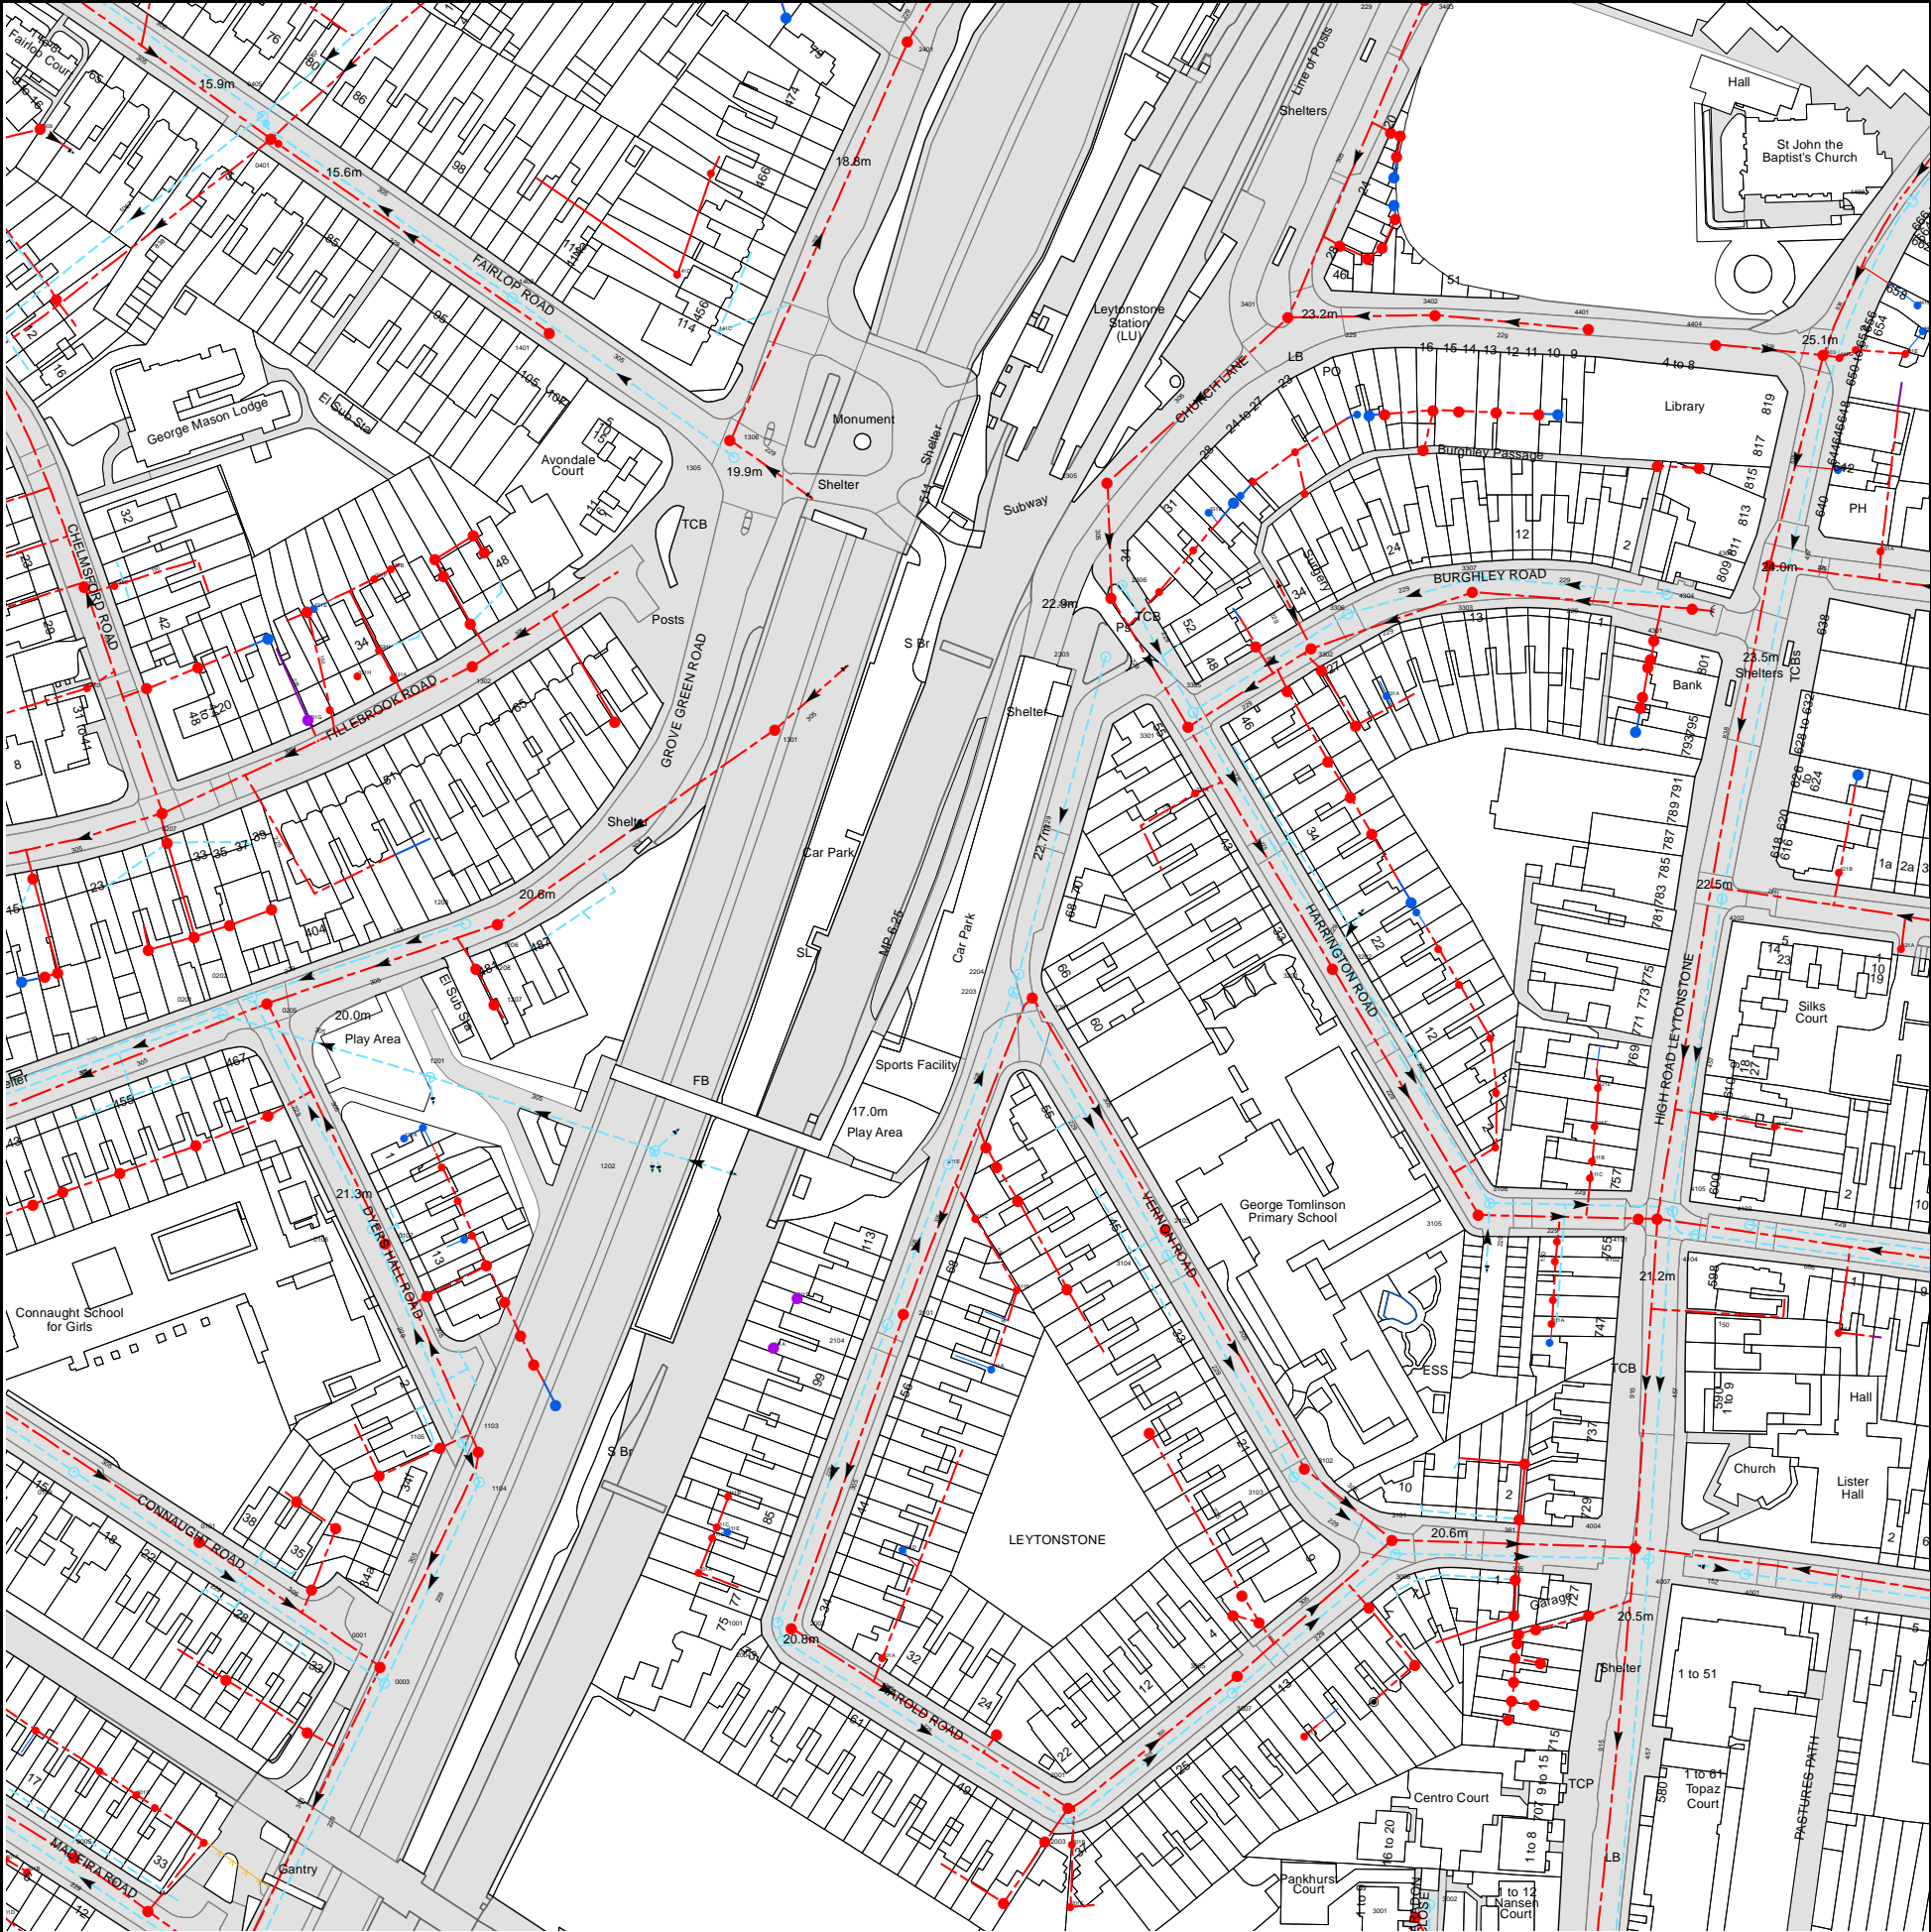


The width of the displayed area is 500m and the centre of the map is located at OS coordinates 539250,187250

The position of the apparatus shown on this plan is given without obligation and warranty, and the accuracy cannot be guaranteed. Service pipes are not shown but their presence should be anticipated. No liability of any kind whatsoever is accepted by Thames Water for any error or omission. The actual position of mains and services must be verified and established on site before any works are undertaken.

Based on the Ordnance Survey Map with the Sanction of the controller of H.M. Stationery Office, License no. 100019345 Crown Copyright Reserved.

B4 Electricity

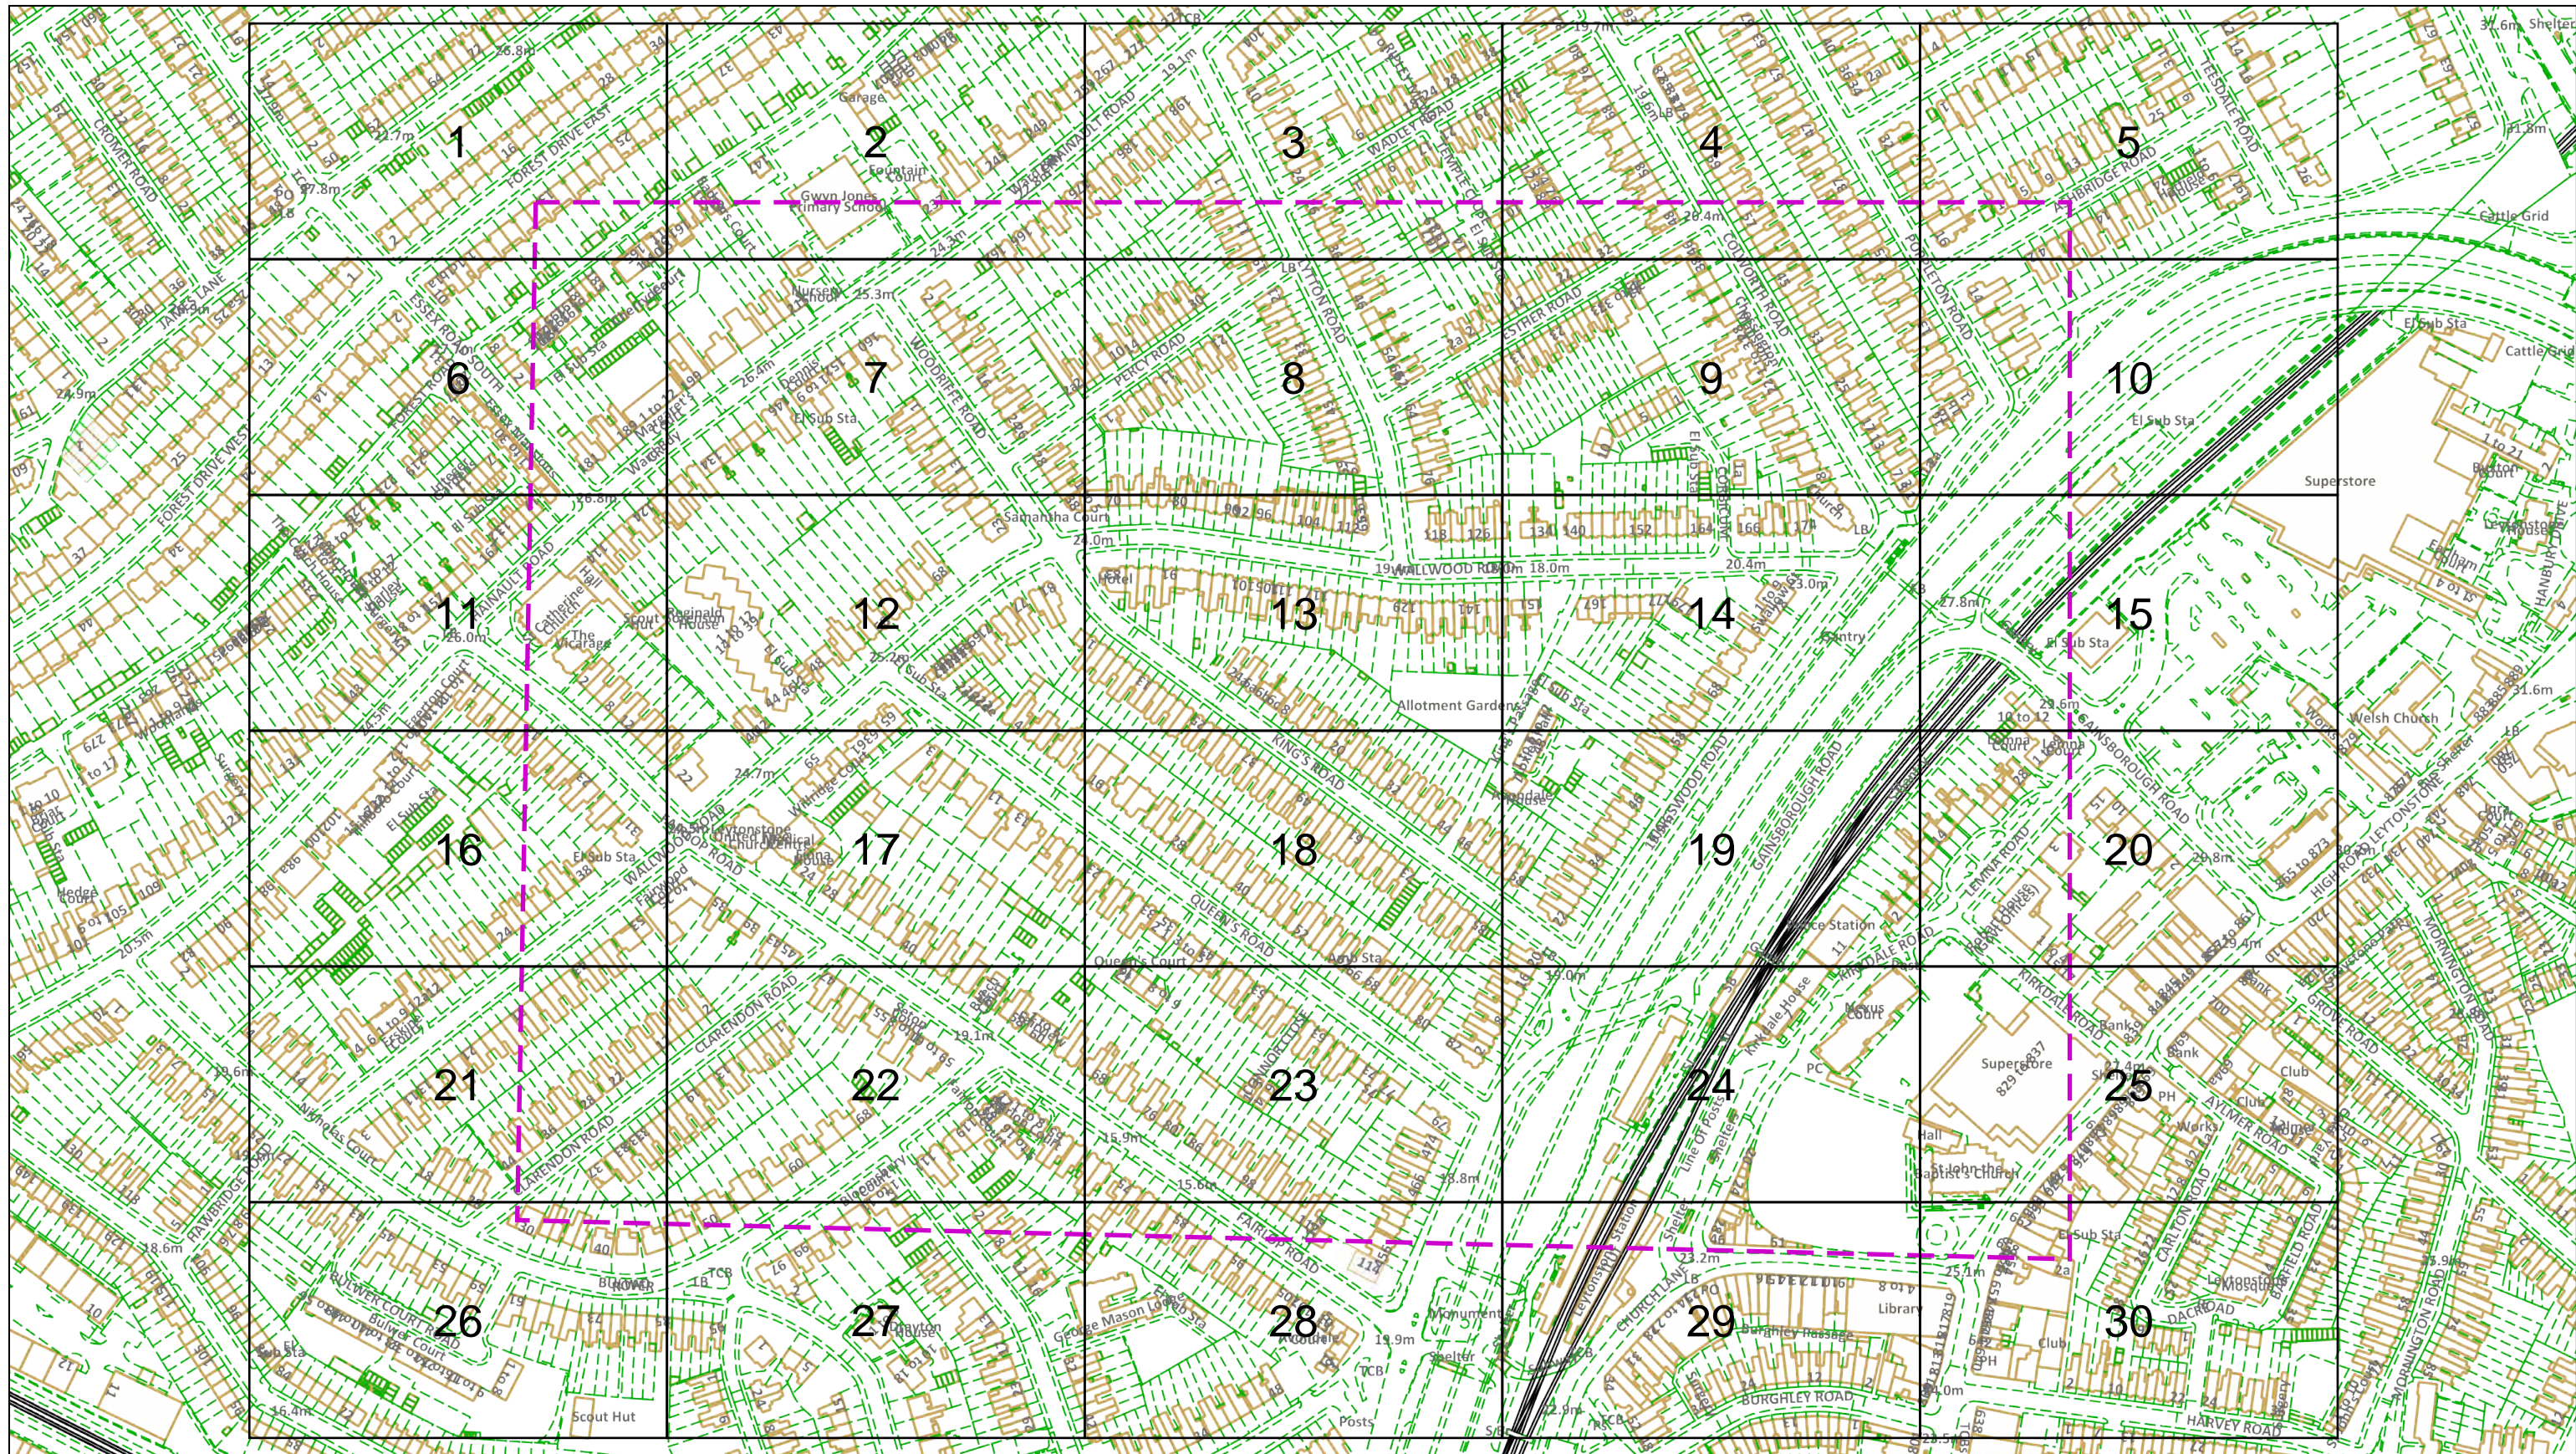

Dig Sites Area: Line:

The quality and accuracy of any print will depend on your printer, your computer and its print settings. Measurements scaled from this plan may not match measurements between the same points on the ground.

This plan must be used with
the attached 'Symbols'
document.

Date Requested: 23/10/2019
Job Reference: 16788601
Site Location: 538584 187257
Requested by:
Mr Duncan Phillips
Your Scheme/Reference: 7152120

Scale: 1:3075 (When plotted at A3)

1. The position of the apparatus shown on this drawing is believed to be correct but the original landmarks may have been altered since the apparatus was installed.
2. The exact position of the apparatus should be verified - use approved cable avoidance tools prior to excavation using suitable hand tools.
3. It is essential that trial holes are carefully made avoiding the use of mechanical tools or picks until the exact location of all the cables have been determined.
4. It must be assumed that there is a service cable into each property, lamp column and street sign, etc.
5. All cables must be treated as being live unless proved otherwise by UK Power Networks.
6. The information proved must be given to all people working near UK Power Networks plant and equipment. Do not use plans more than 3 months after the issue date for excavation purposes.
7. Please be aware that electric cables/lines belonging to other owners of licensed electricity distribution systems may be present and it is your responsibility to identify their location.

1. UK Power Networks does not warrant that the information provided to you is correct. You rely upon it at your own risk.
2. UK Power Networks does not exclude or limit its liability if it causes the death of any persons or causes personal injury to a person.
3. Subject to paragraph 2 UK Power Networks has no liability to you in contract, in tort (including negligence), for breach of statutory duty or otherwise for any loss, damage, cost, claims, demands, or expenses that you or any third party may suffer or incur as a result of using the information provided whether for physical damage to property or for any economic loss (including without limitation loss of profit, loss of opportunity, loss of savings, loss of goodwill, loss of business, loss of use) or any special or consequential loss or damage whatsoever.
4. This plan has been provided to you on the basis of the terms of use set out in the covering letter that accompanies this plan. If you do not accept and/or do not understand the terms of use set out in the covering letter you must not use the plan and must return it to the sender of the letter.
5. You are responsible for the security of the information provided to you. It must not be given, sold or made available upon payment of a fee to a third party.




IF IN DOUBT - ASK!
PHONE 0800 056 5866
EMERGENCY - If you
damage a cable or line
Phone 0800 783 8838
(24hrs) URGENTLY




ALWAYS LOOK UP
BEFORE
YOU START WORK
Refer to HSE
Guidance note GS6

Maps produced at 1:2500 scale are Geo-Schematics which show LV mains cables and overhead lines (in some cases all voltages). Prior to carrying out excavations you must refer to the 1:500 records to determine the location of all known underground plant and equipment.


Reproduced by permission of Ordnance Survey on behalf of HMSO. © Crown copyright and database rights 2019. All rights reserved. Ordnance Survey Licence numbers 100019626, 100019826 and 100019450. Data has been added to the Ordnance Survey base map; all proprietary rights in such additional data are and shall remain the exclusive property of © London Power Networks plc or Eastern Power Networks plc or South Eastern Power Networks plc each being a distribution licensee under section 6(1)(c) of the Electricity Act 1989 for the relevant distribution services area as that term is defined in such licensee's distribution licence. All rights in such data reserved.
Plans generated by DigSAFE Pro™ software provided by LinesearchbeforeUdig.

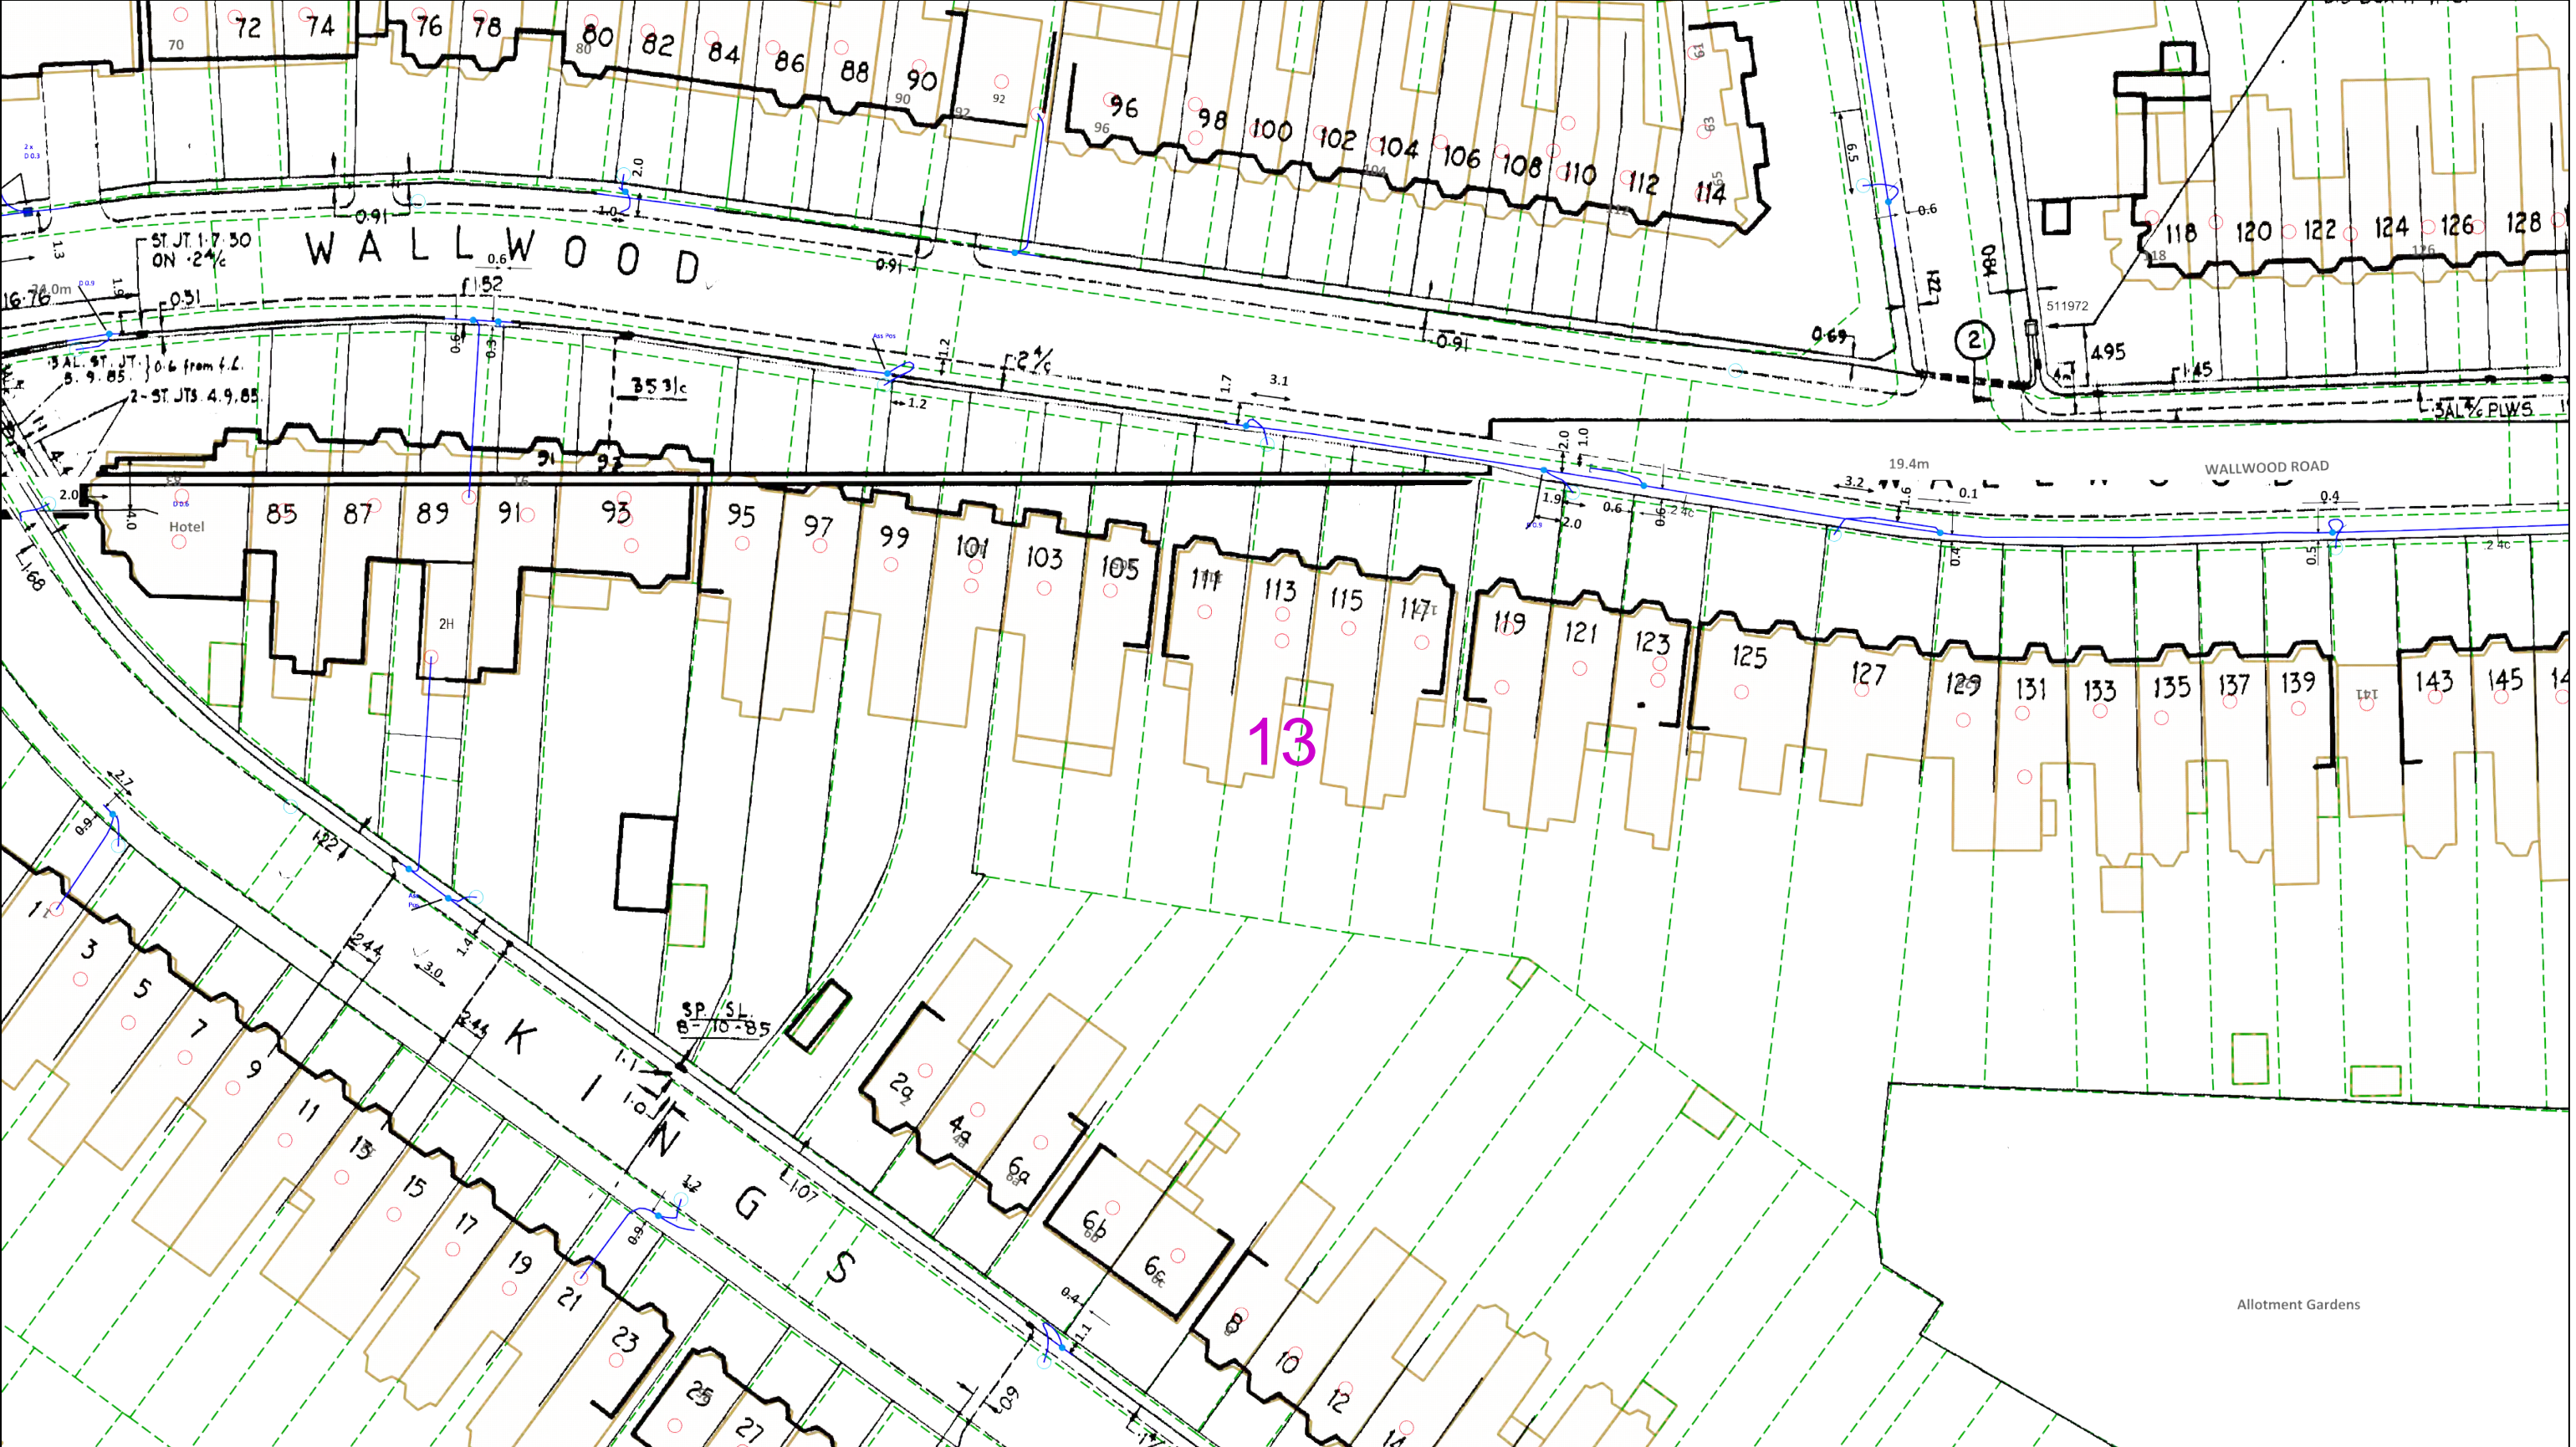

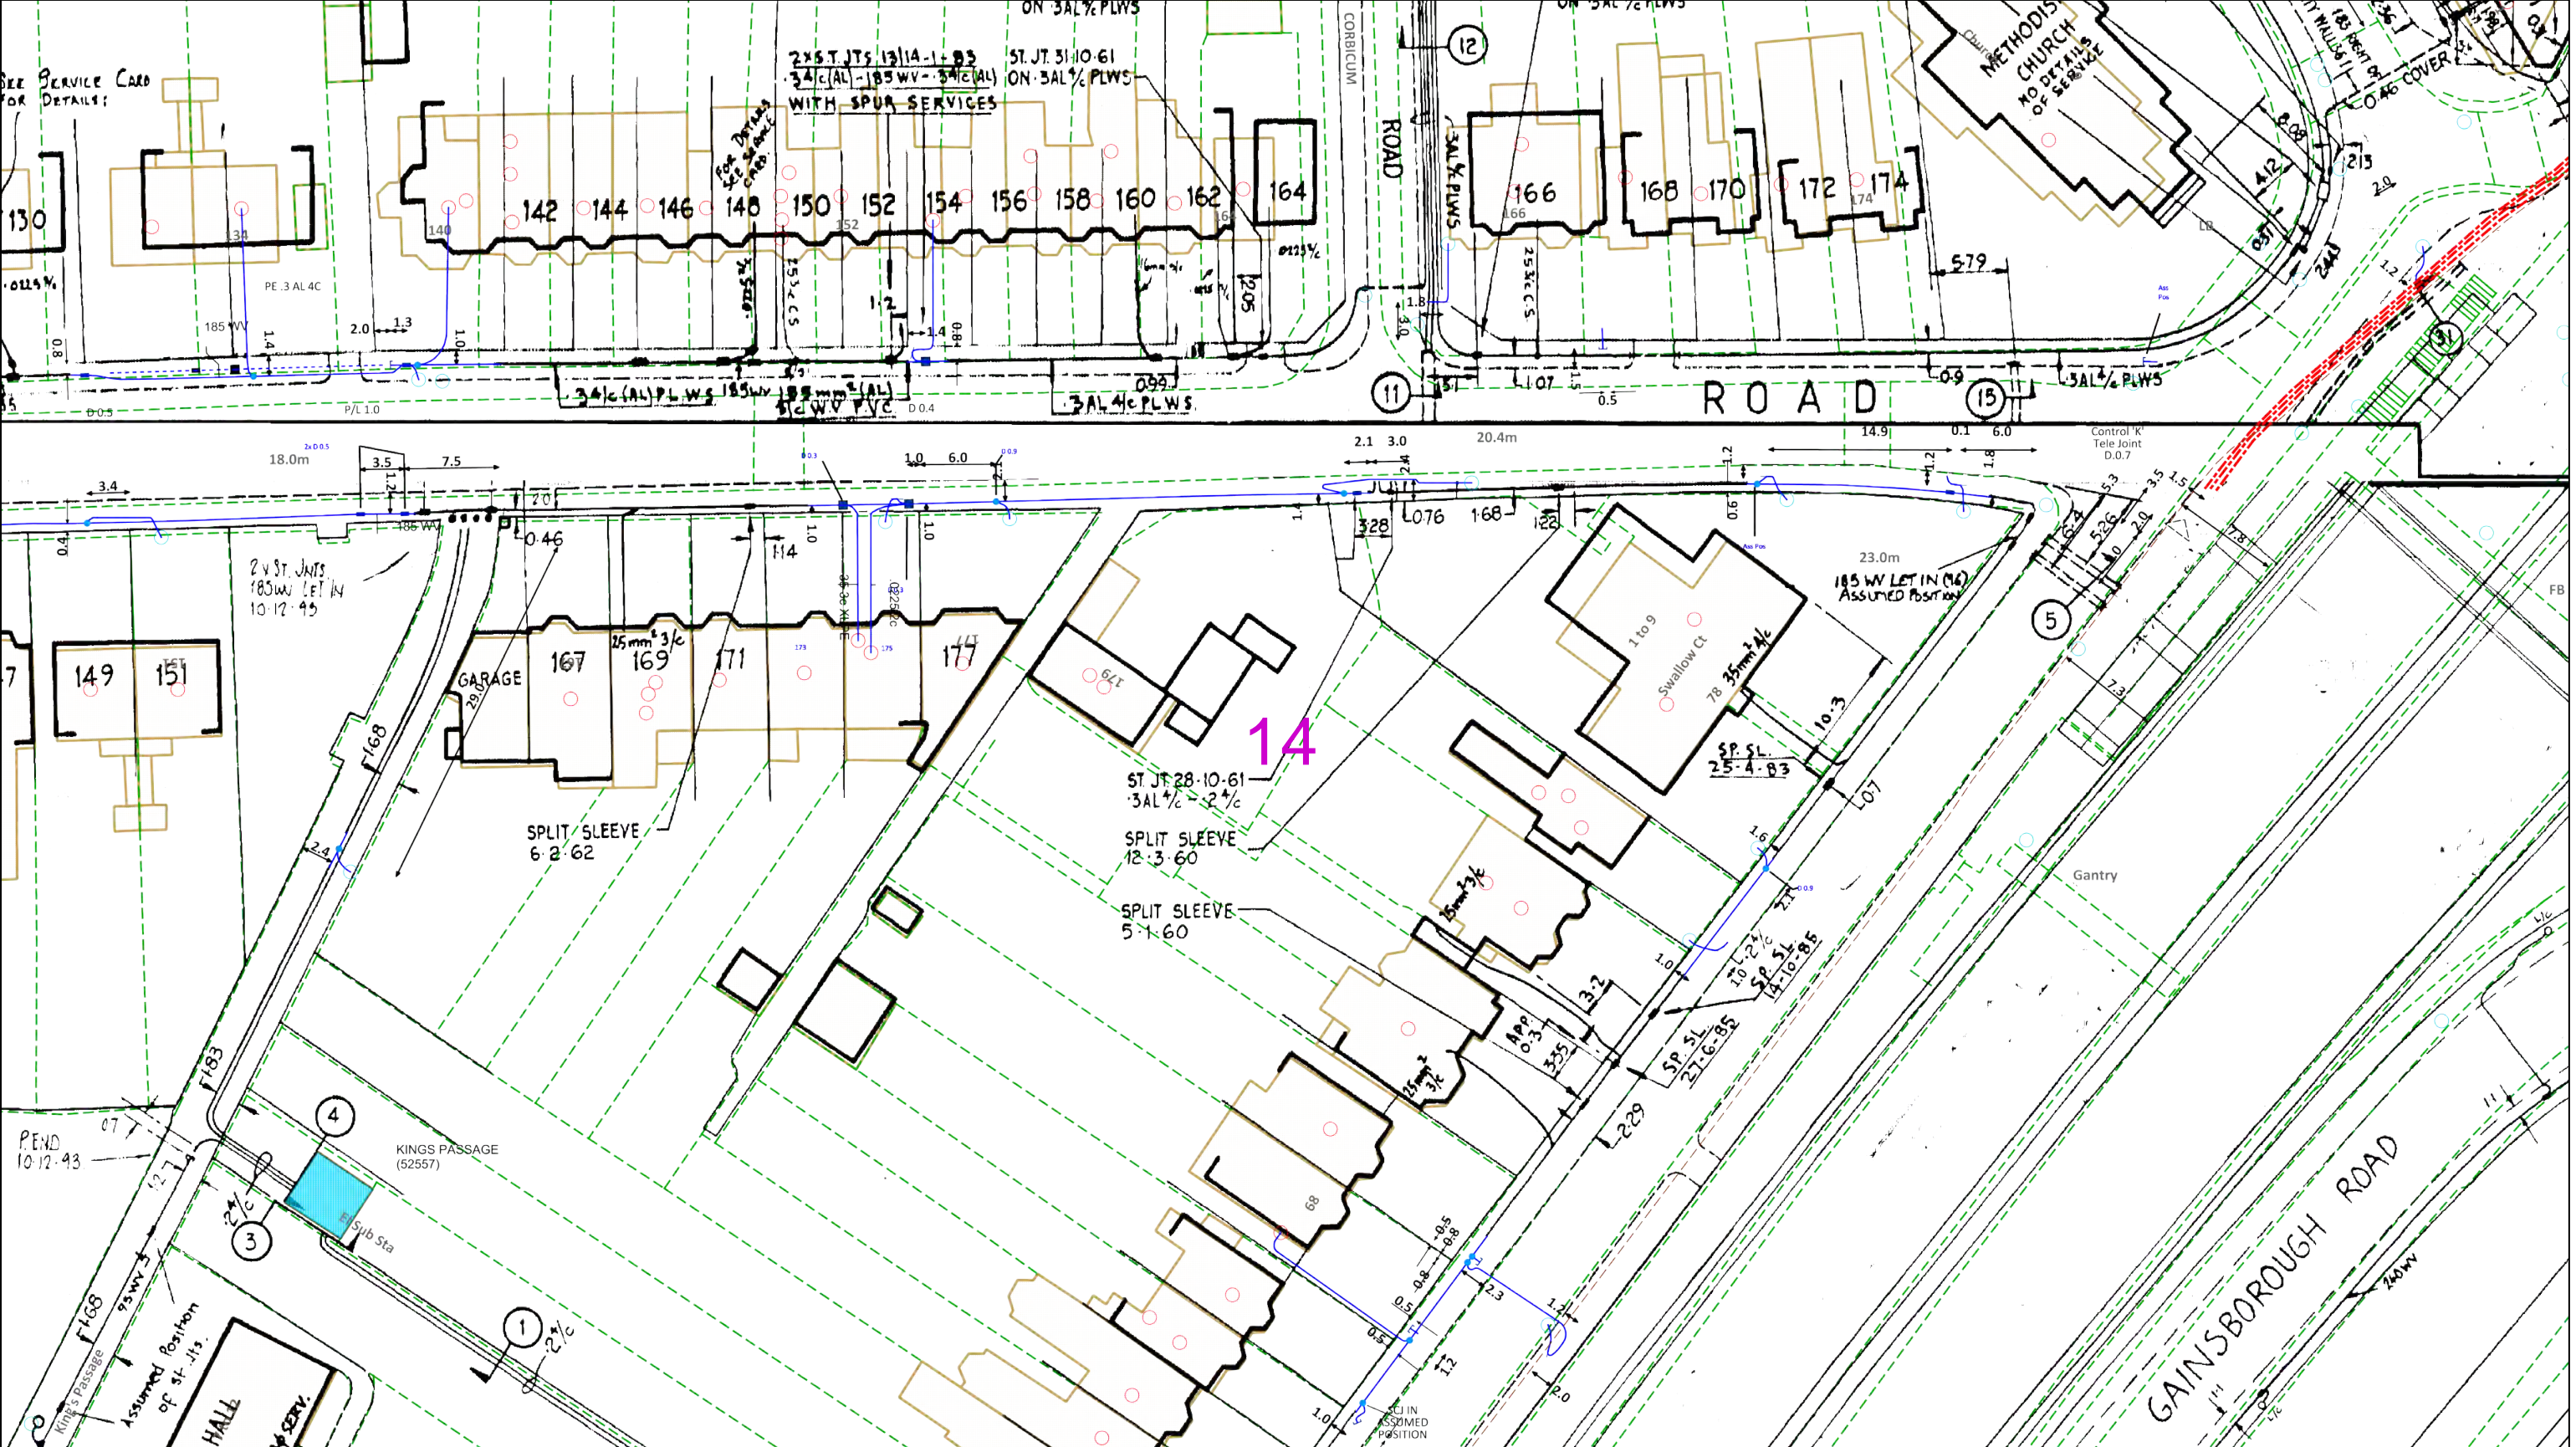


<p>0 25 50 metres</p> <p>This plan must be used with the attached 'Symbols' document.</p> <p>Date Requested: 23/10/2019 Job Reference: 16788601 Site Location: 538584 187257 Requested by: Mr Duncan Phillips Your Scheme/Reference: 7152120</p> <p>Scale: 1:500 (When plotted at A3)</p>		<p>1. The position of the apparatus shown on this drawing is believed to be correct but the original landmarks may have been altered since the apparatus was installed.</p> <p>2. The exact position of the apparatus should be verified - use approved cable avoidance tools prior to excavation using suitable hand tools.</p> <p>3. It is essential that trial holes are carefully made avoiding the use of mechanical tools or picks until the exact location of all the cables have been determined.</p> <p>4. It must be assumed that there is a service cable into each property, lamp column and street sign, etc.</p> <p>5. All cables must be treated as being live unless proved otherwise by UK Power Networks.</p> <p>6. The information proved must be given to all people working near UK Power Networks plant and equipment. Do not use plans more than 3 months after the issue date for excavation purposes.</p> <p>7. Please be aware that electric cables/lines belonging to other owners of licensed electricity distribution systems may be present and it is your responsibility to identify their location.</p>	<p>1. UK Power Networks does not warrant that the information provided to you is correct. You rely upon it at your own risk.</p> <p>2. UK Power Networks does not exclude or limit its liability if it causes the death of any persons or causes personal injury to a person.</p> <p>3. Subject to paragraph 2 UK Power Networks has no liability to you in contract, in tort (including negligence), for breach of statutory duty or otherwise for any loss, damage, cost, claims, demands, or expenses that you or any third party may suffer or incur as a result of using the information provided whether for physical damage to property or for any economic loss (including without limitation loss of profit, loss of opportunity, loss of savings, loss of goodwill, loss of business, loss of use) or any special or consequential loss or damage whatsoever.</p> <p>4. This plan has been provided to you on the basis of the terms of use set out in the covering letter that accompanies this plan. If you do not accept and/or do not understand the terms of use set out in the covering letter you must not use the plan and must return it to the sender of the letter.</p> <p>5. You are responsible for the security of the information provided to you. It must not be given, sold or made available upon payment of a fee to a third party.</p>	<p>IF IN DOUBT - ASK! PHONE 0800 056 5866 EMERGENCY - If you damage a cable or line Phone 0800 783 8838 (24hrs) URGENTLY</p> <p>ALWAYS LOOK UP BEFORE YOU START WORK Refer to HSE Guidance note GS6</p>
<p>Reproduced by permission of Ordnance Survey on behalf of HMSO. © Crown copyright and database rights 2019. All rights reserved. Ordnance Survey Licence numbers 100019626, 100019826 and 100019450. Data has been added to the Ordnance Survey base map; all proprietary rights in such additional data are and shall remain the exclusive property of © London Power Networks plc or Eastern Power Networks plc or South Eastern Power Networks plc each being a distribution licensee under section 6(1)(c) of the Electricity Act 1989 for the relevant distribution services area as that term is defined in such licensee's distribution licence. All rights in such data reserved.</p> <p>Plans generated by DigSAFE Pro™ software provided by LinesearchbeforeUdig.</p>				

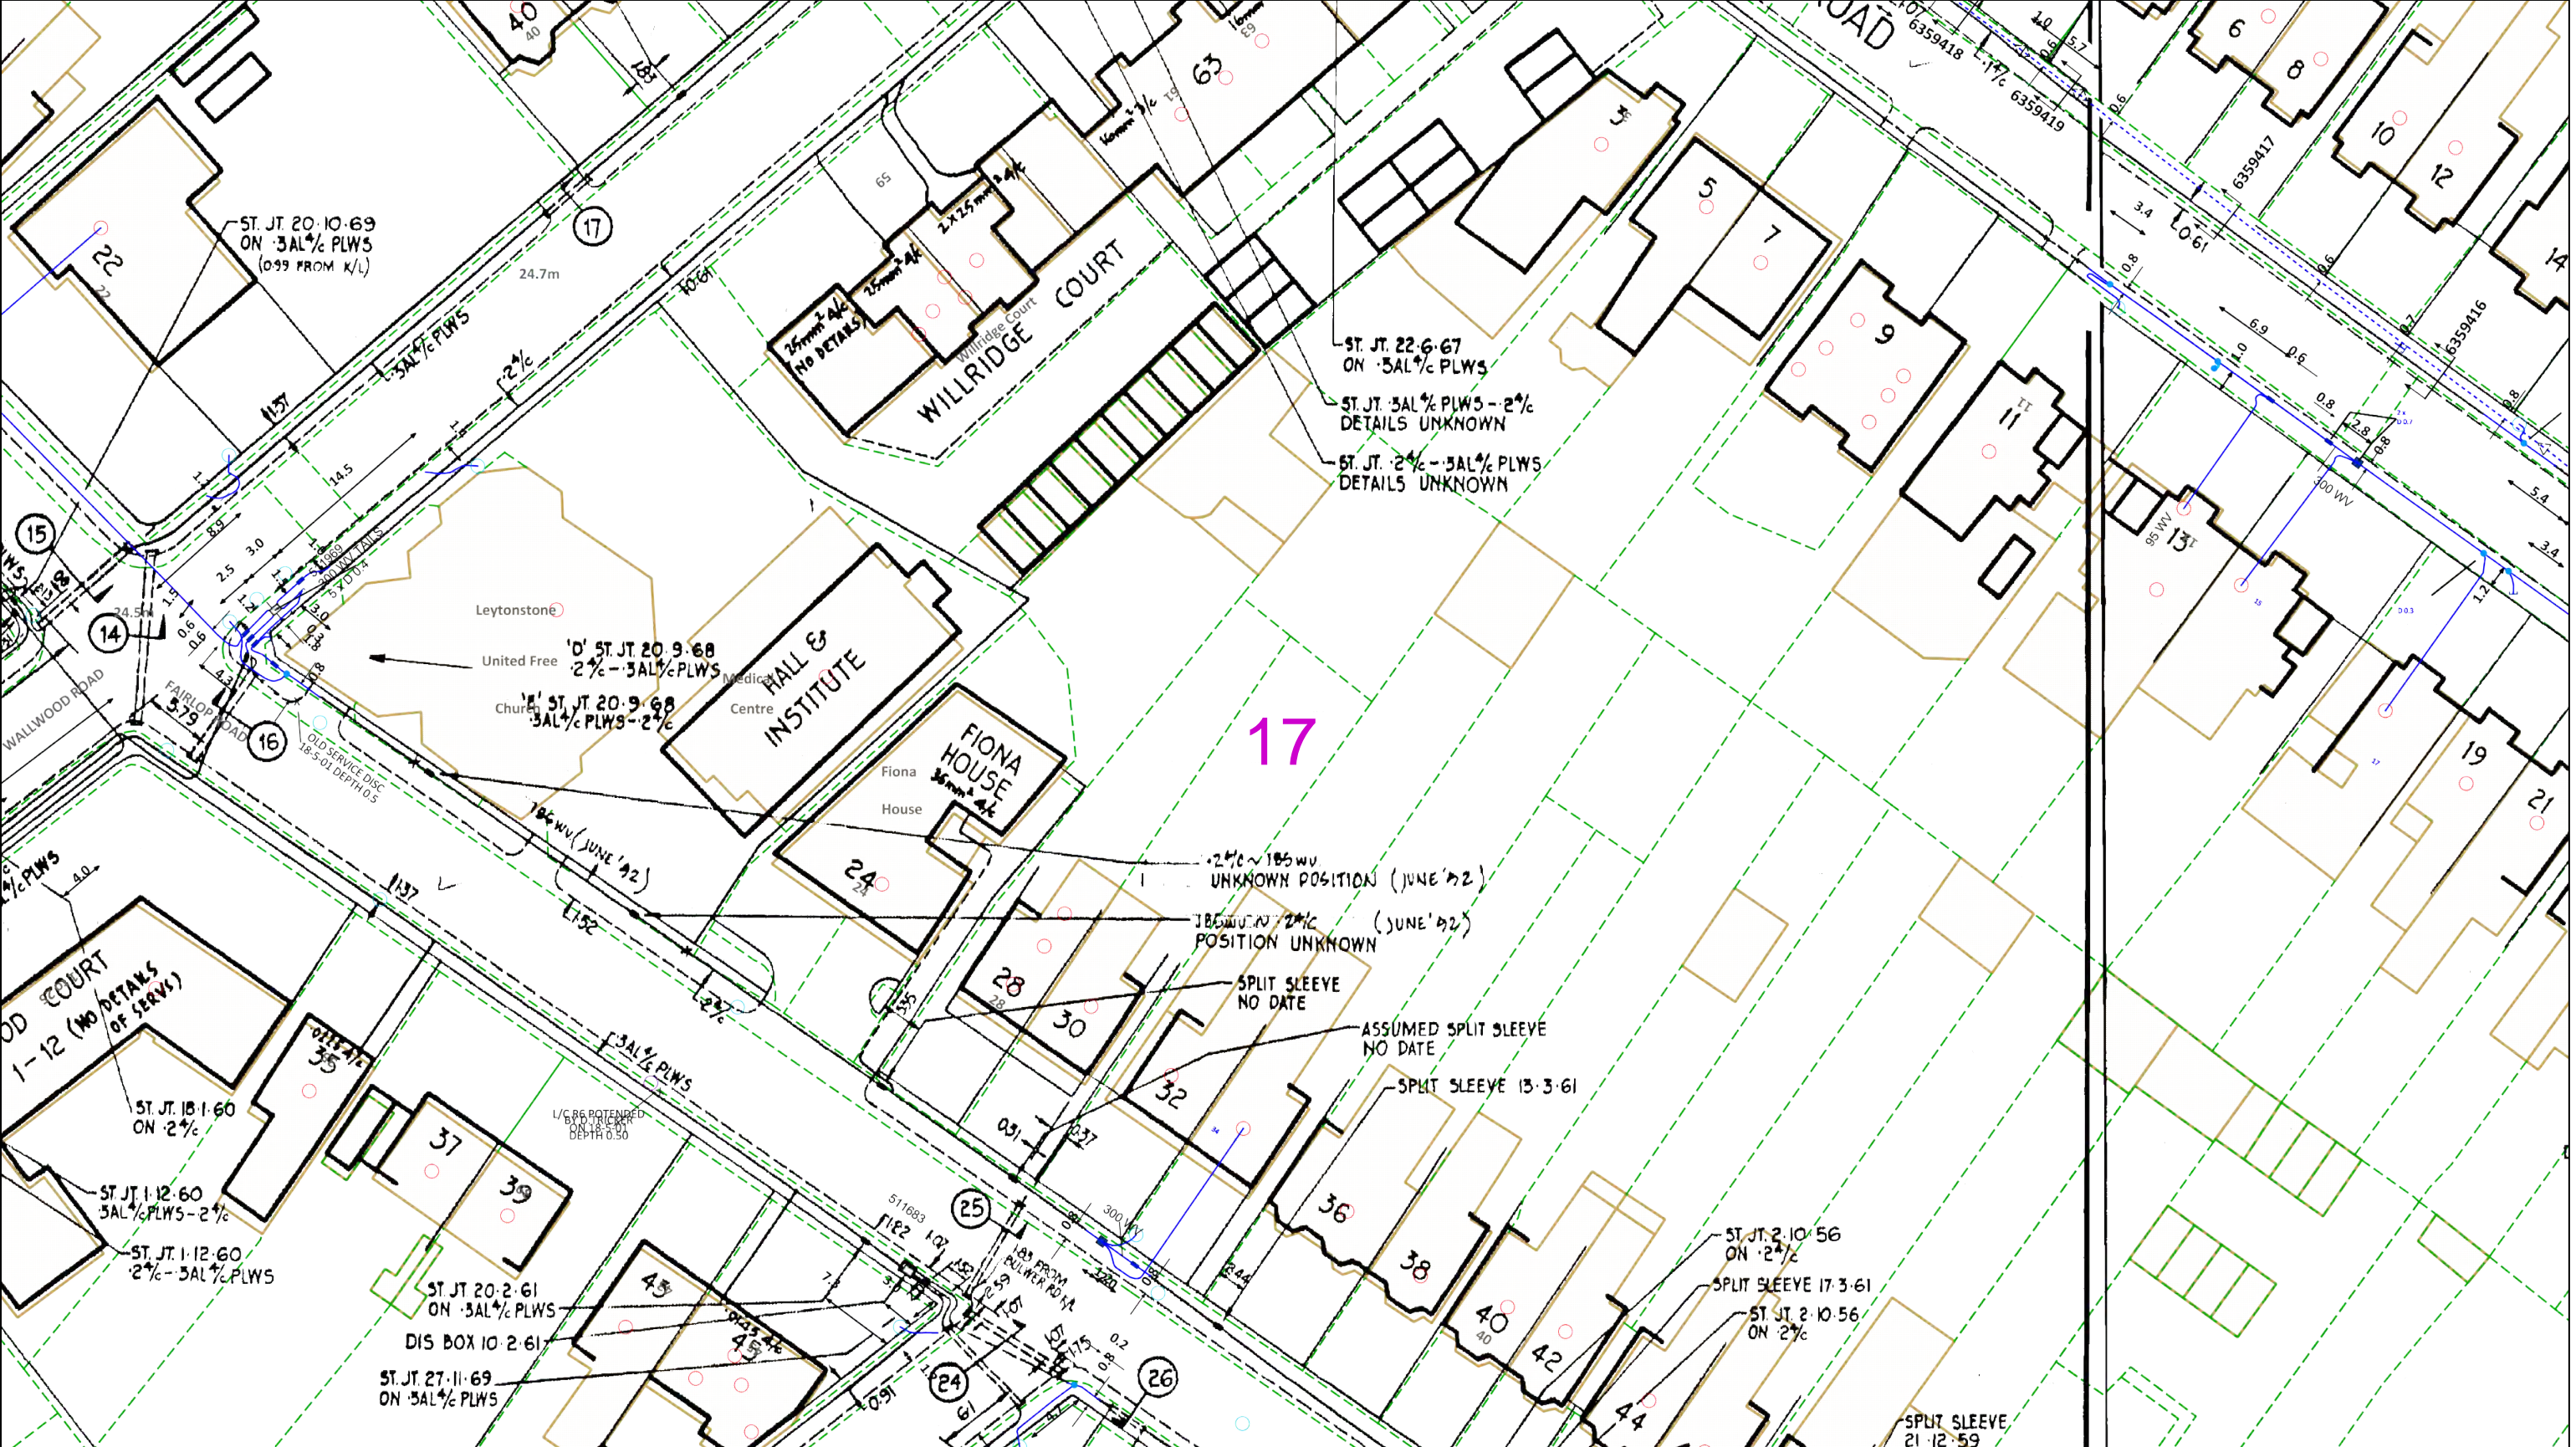

<p>This plan must be used with the attached 'Symbols' document.</p> <p>Date Requested: 23/10/2019 Job Reference: 16788601 Site Location: 538584 187257 Requested by: Mr Duncan Phillips Your Scheme/Reference: 7152120</p> <p>Scale: 1:500 (When plotted at A3)</p>		<p>1. The position of the apparatus shown on this drawing is believed to be correct but the original landmarks may have been altered since the apparatus was installed.</p> <p>2. The exact position of the apparatus should be verified - use approved cable avoidance tools prior to excavation using suitable hand tools.</p> <p>3. It is essential that trial holes are carefully made avoiding the use of mechanical tools or picks until the exact location of all the cables have been determined.</p> <p>4. It must be assumed that there is a service cable into each property, lamp column and street sign, etc.</p> <p>5. All cables must be treated as being live unless proved otherwise by UK Power Networks.</p> <p>6. The information proved must be given to all people working near UK Power Networks plant and equipment. Do not use plans more than 3 months after the issue date for excavation purposes.</p> <p>7. Please be aware that electric cables/lines belonging to other owners of licensed electricity distribution systems may be present and it is your responsibility to identify their location.</p>	<p>1. UK Power Networks does not warrant that the information provided to you is correct. You rely upon it at your own risk.</p> <p>2. UK Power Networks does not exclude or limit its liability if it causes the death of any persons or causes personal injury to a person.</p> <p>3. Subject to paragraph 2 UK Power Networks has no liability to you in contract, in tort (including negligence), for breach of statutory duty or otherwise for any loss, damage, cost, claims, demands, or expenses that you or any third party may suffer or incur as a result of using the information provided whether for physical damage to property or for any economic loss (including without limitation loss of profit, loss of opportunity, loss of savings, loss of goodwill, loss of business, loss of use) or any special or consequential loss or damage whatsoever.</p> <p>4. This plan has been provided to you on the basis of the terms of use set out in the covering letter that accompanies this plan. If you do not accept and/or do not understand the terms of use set out in the covering letter you must not use the plan and must return it to the sender of the letter.</p> <p>5. You are responsible for the security of the information provided to you. It must not be given, sold or made available upon payment of a fee to a third party.</p>	<div></div> <div></div> <div><p>IF IN DOUBT - ASK! PHONE 0800 056 5866 EMERGENCY - If you damage a cable or line Phone 0800 783 8838 (24hrs) URGENTLY</p></div> <div></div> <div><p>ALWAYS LOOK UP BEFORE YOU START WORK Refer to HSE Guidance note GS6</p></div>
<p>Reproduced by permission of Ordnance Survey on behalf of HMSO. © Crown copyright and database rights 2019. All rights reserved. Ordnance Survey Licence numbers 100019626, 100019826 and 100019450. Data has been added to the Ordnance Survey base map; all proprietary rights in such additional data are and shall remain the exclusive property of © London Power Networks plc or Eastern Power Networks plc or South Eastern Power Networks plc each being a distribution licensee under section 6(1)(c) of the Electricity Act 1989 for the relevant distribution services area as that term is defined in such licensee's distribution licence. All rights in such data reserved.</p> <p>Plans generated by DigSAFE Pro™ software provided by LinesearchbeforeUdig.</p>				



<p>This plan must be used with the attached 'Symbols' document.</p> <p>Date Requested: 23/10/2019 Job Reference: 16788601 Site Location: 538584 187257 Requested by: Mr Duncan Phillips Your Scheme/Reference: 7152120</p> <p>Scale: 1:500 (When plotted at A3)</p>		<p>1. The position of the apparatus shown on this drawing is believed to be correct but the original landmarks may have been altered since the apparatus was installed.</p> <p>2. The exact position of the apparatus should be verified - use approved cable avoidance tools prior to excavation using suitable hand tools.</p> <p>3. It is essential that trial holes are carefully made avoiding the use of mechanical tools or picks until the exact location of all the cables have been determined.</p> <p>4. It must be assumed that there is a service cable into each property, lamp column and street sign, etc.</p> <p>5. All cables must be treated as being live unless proved otherwise by UK Power Networks.</p> <p>6. The information proved must be given to all people working near UK Power Networks plant and equipment. Do not use plans more than 3 months after the issue date for excavation purposes.</p> <p>7. Please be aware that electric cables/lines belonging to other owners of licensed electricity distribution systems may be present and it is your responsibility to identify their location.</p>	<p>1. UK Power Networks does not warrant that the information provided to you is correct. You rely upon it at your own risk.</p> <p>2. UK Power Networks does not exclude or limit its liability if it causes the death of any persons or causes personal injury to a person.</p> <p>3. Subject to paragraph 2 UK Power Networks has no liability to you in contract, in tort (including negligence), for breach of statutory duty or otherwise for any loss, damage, cost, claims, demands, or expenses that you or any third party may suffer or incur as a result of using the information provided whether for physical damage to property or for any economic loss (including without limitation loss of profit, loss of opportunity, loss of savings, loss of goodwill, loss of business, loss of use) or any special or consequential loss or damage whatsoever.</p> <p>4. This plan has been provided to you on the basis of the terms of use set out in the covering letter that accompanies this plan. If you do not accept and/or do not understand the terms of use set out in the covering letter you must not use the plan and must return it to the sender of the letter.</p> <p>5. You are responsible for the security of the information provided to you. It must not be given, sold or made available upon payment of a fee to a third party.</p>	<div><p>IF IN DOUBT - ASK! PHONE 0800 056 5866 EMERGENCY - If you damage a cable or line Phone 0800 783 8838 (24hrs) URGENTLY</p></div> <div><p>ALWAYS LOOK UP BEFORE YOU START WORK Refer to HSE Guidance note GS6</p></div> <p>Maps produced at 1:2500 scale are Geo-Schematics which show LV mains cables and overhead lines (in some cases all voltages). Prior to carrying out excavations you must refer to the 1:500 records to determine the location of all known underground plant and equipment.</p>
<p>Reproduced by permission of Ordnance Survey on behalf of HMSO. © Crown copyright and database rights 2019. All rights reserved. Ordnance Survey Licence numbers 100019626, 100019826 and 100019450. Data has been added to the Ordnance Survey base map; all proprietary rights in such additional data are and shall remain the exclusive property of © London Power Networks plc or Eastern Power Networks plc or South Eastern Power Networks plc each being a distribution licensee under section 6(1)(c) of the Electricity Act 1989 for the relevant distribution services area as that term is defined in such licensee's distribution licence. All rights in such data reserved.</p> <p>Plans generated by DigSAFE Pro™ software provided by LinesearchbeforeUdig.</p>				

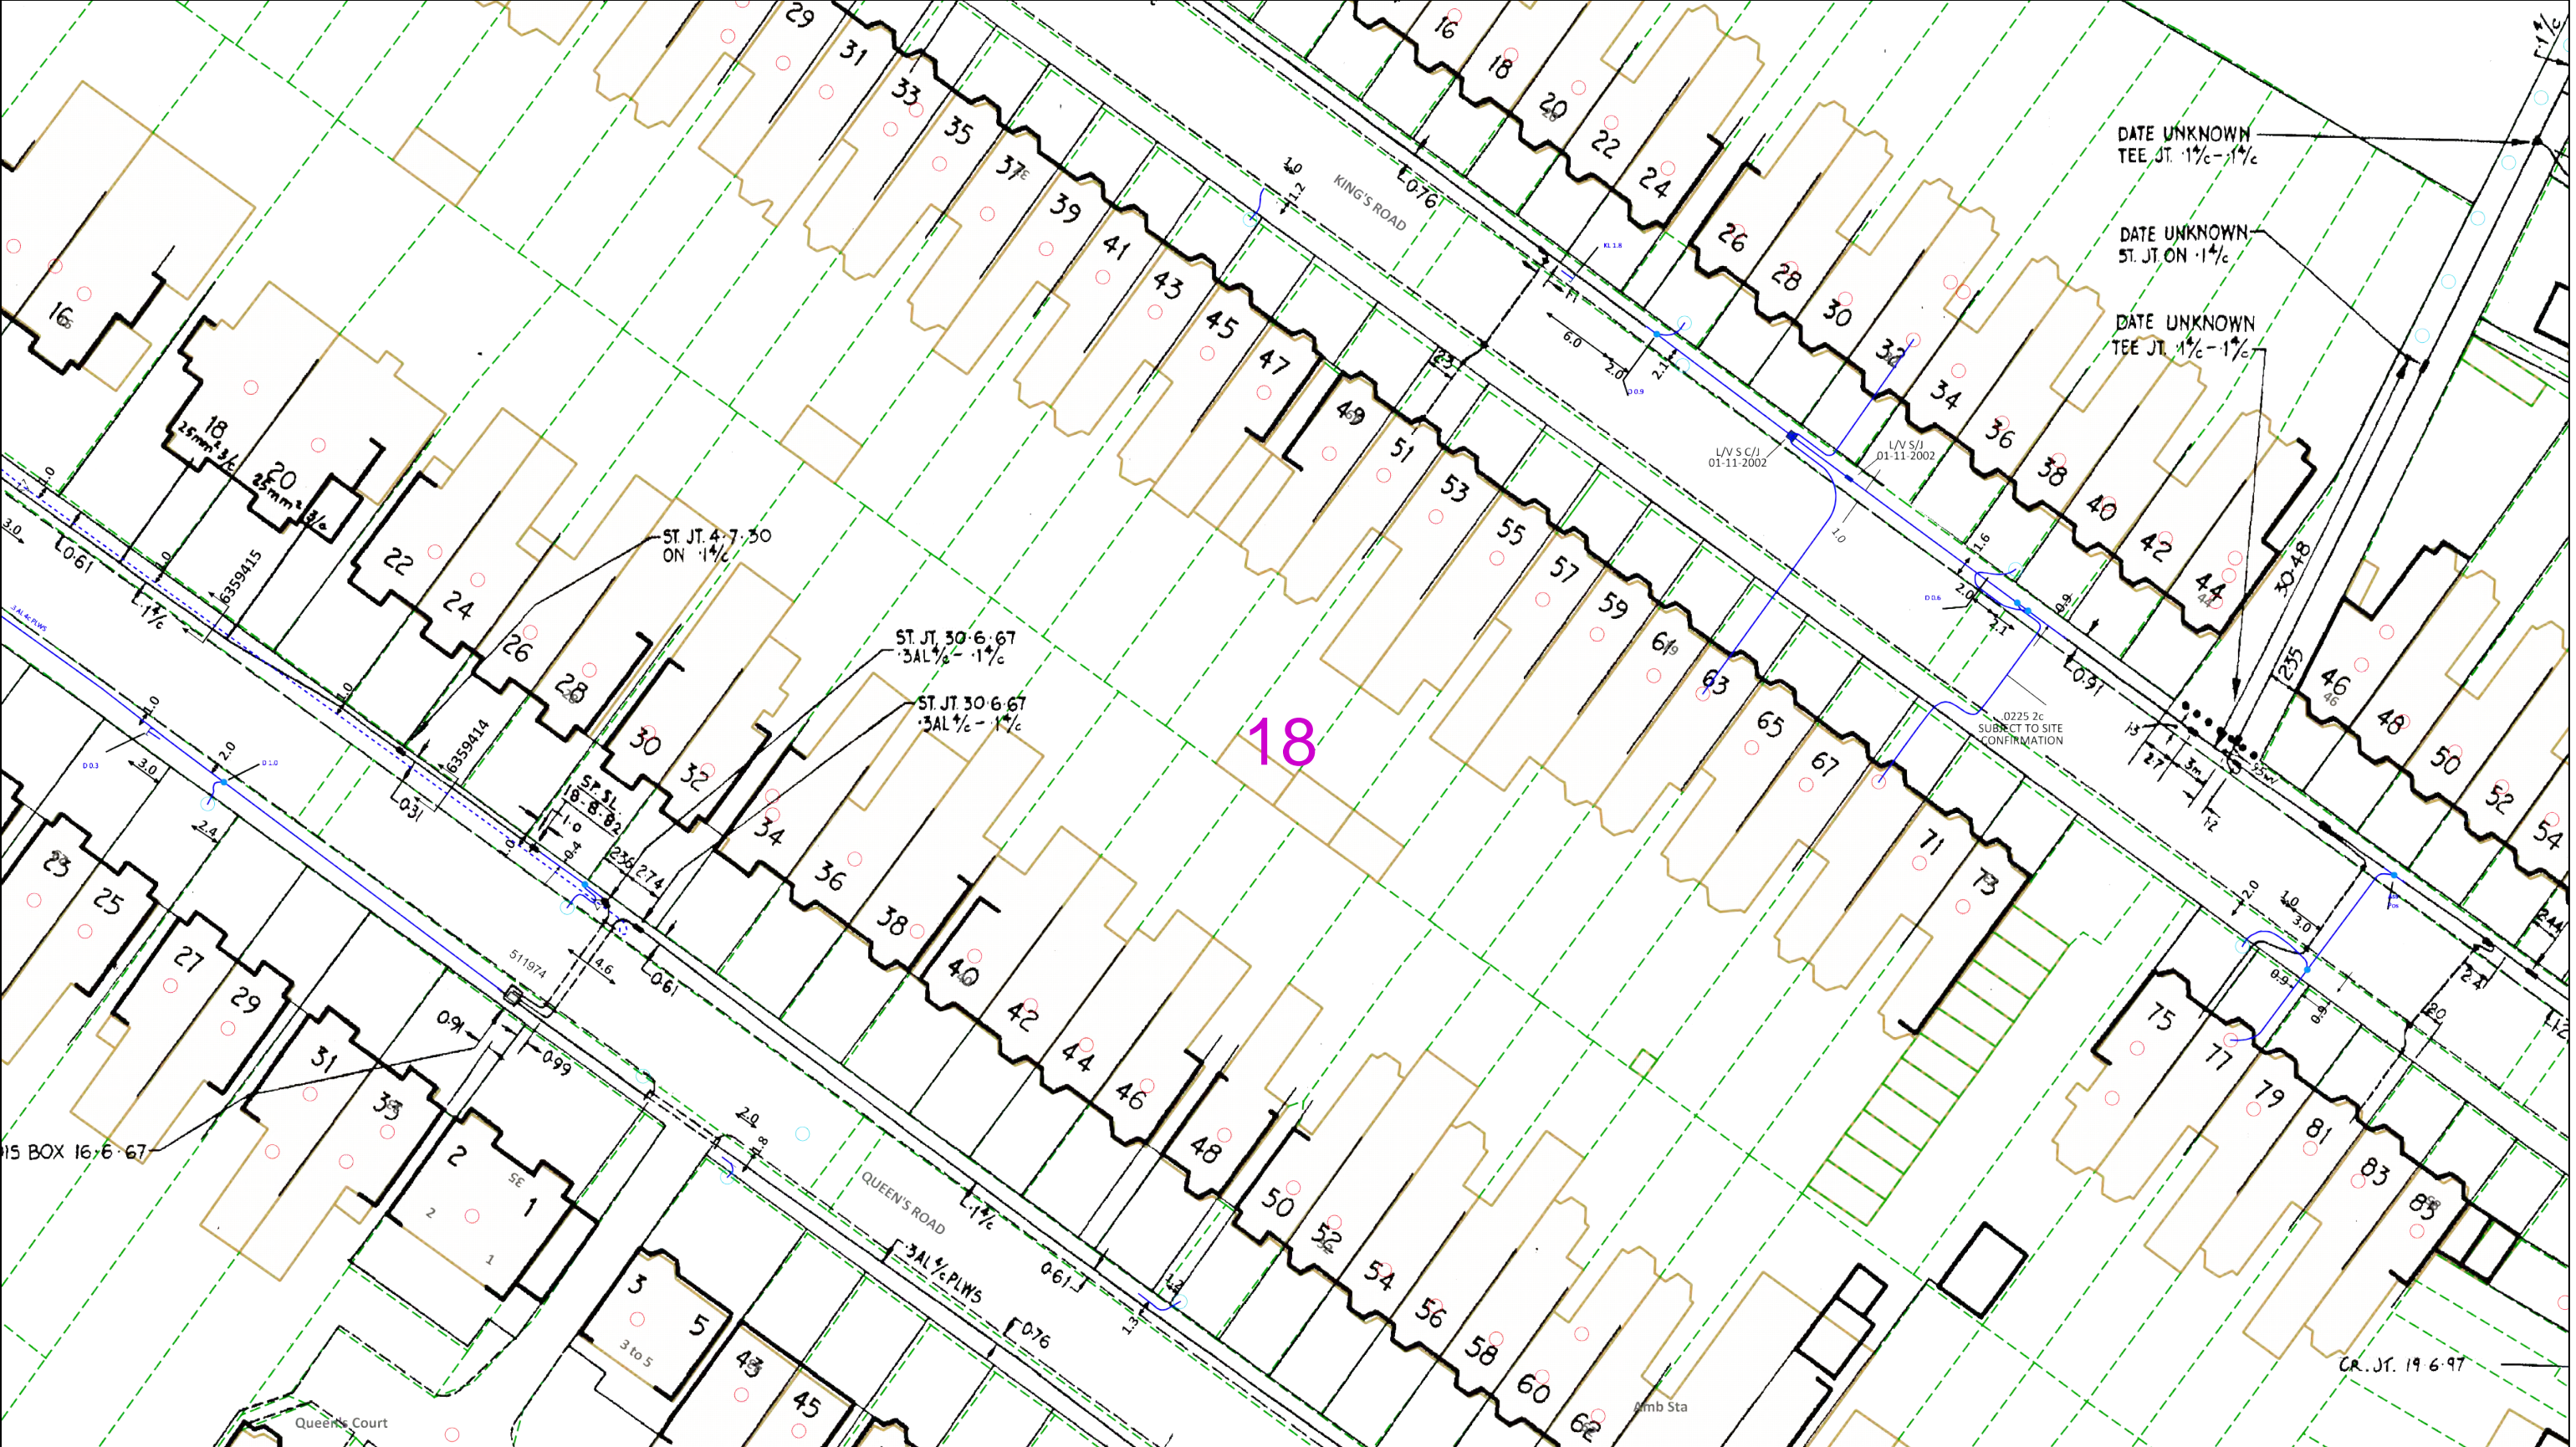

0 25 50

metres

Dig Sites Area: Line:

The quality and accuracy of any print will depend on your printer, your computer and its print settings. Measurements scaled from this plan may not match measurements between the same points on the ground.

UK Power Networks

IF IN DOUBT - ASK!
PHONE 0800 056 5866
EMERGENCY - If you
damage a cable or line
Phone 0800 783 8838
(24hrs) URGENTLY

ALWAYS LOOK UP
BEFORE
YOU START WORK
Refer to HSE
Guidance note GS6

This plan must be used with the attached 'Symbols' document.

Date Requested: 23/10/2019
Job Reference: 16788601
Site Location: 538584 187257
Requested by:
Mr Duncan Phillips
Your Scheme/Reference: 7152120

Scale: 1:500 (When plotted at A3)

1. The position of the apparatus shown on this drawing is believed to be correct but the original landmarks may have been altered since the apparatus was installed.

2. The exact position of the apparatus should be verified - use approved cable avoidance tools prior to excavation using suitable hand tools.

3. It is essential that trial holes are carefully made avoiding the use of mechanical tools or picks until the exact location of all the cables have been determined.

4. It must be assumed that there is a service cable into each property, lamp column and street sign, etc.

5. All cables must be treated as being live unless proved otherwise by UK Power Networks.

6. The information proved must be given to all people working near UK Power Networks plant and equipment. Do not use plans more than 3 months after the issue date for excavation purposes.

7. Please be aware that electric cables/lines belonging to other owners of licensed electricity distribution systems may be present and it is your responsibility to identify their location.

1. UK Power Networks does not warrant that the information provided to you is correct. You rely upon it at your own risk.

2. UK Power Networks does not exclude or limit its liability if it causes the death of any persons or causes personal injury to a person.


3. Subject to paragraph 2 UK Power Networks has no liability to you in contract, in tort (including negligence), for breach of statutory duty or otherwise for any loss, damage, cost, claims, demands, or expenses that you or any third party may suffer or incur as a result of using the information provided whether for physical damage to property or for any economic loss (including without limitation loss of profit, loss of opportunity, loss of savings, loss of goodwill, loss of business, loss of use) or any special or consequential loss or damage whatsoever.

4. This plan has been provided to you on the basis of the terms of use set out in the covering letter that accompanies this plan. If you do not accept and/or do not understand the terms of use set out in the covering letter you must not use the plan and must return it to the sender of the letter.

5. You are responsible for the security of the information provided to you. It must not be given, sold or made available upon payment of a fee to a third party.

Reproduced by permission of Ordnance Survey on behalf of HMSO. © Crown copyright and database rights 2019. All rights reserved. Ordnance Survey Licence numbers 100019626, 100019826 and 100019450. Data has been added to the Ordnance Survey base map; all proprietary rights in such additional data are and shall remain the exclusive property of © London Power Networks plc or Eastern Power Networks plc or South Eastern Power Networks plc each being a distribution licensee under section 6(1)(c) of the Electricity Act 1989 for the relevant distribution services area as that term is defined in such licensee's distribution licence. All rights in such data reserved.

Plans generated by DigSAFE Pro™ software provided by LinesearchbeforeUdig.

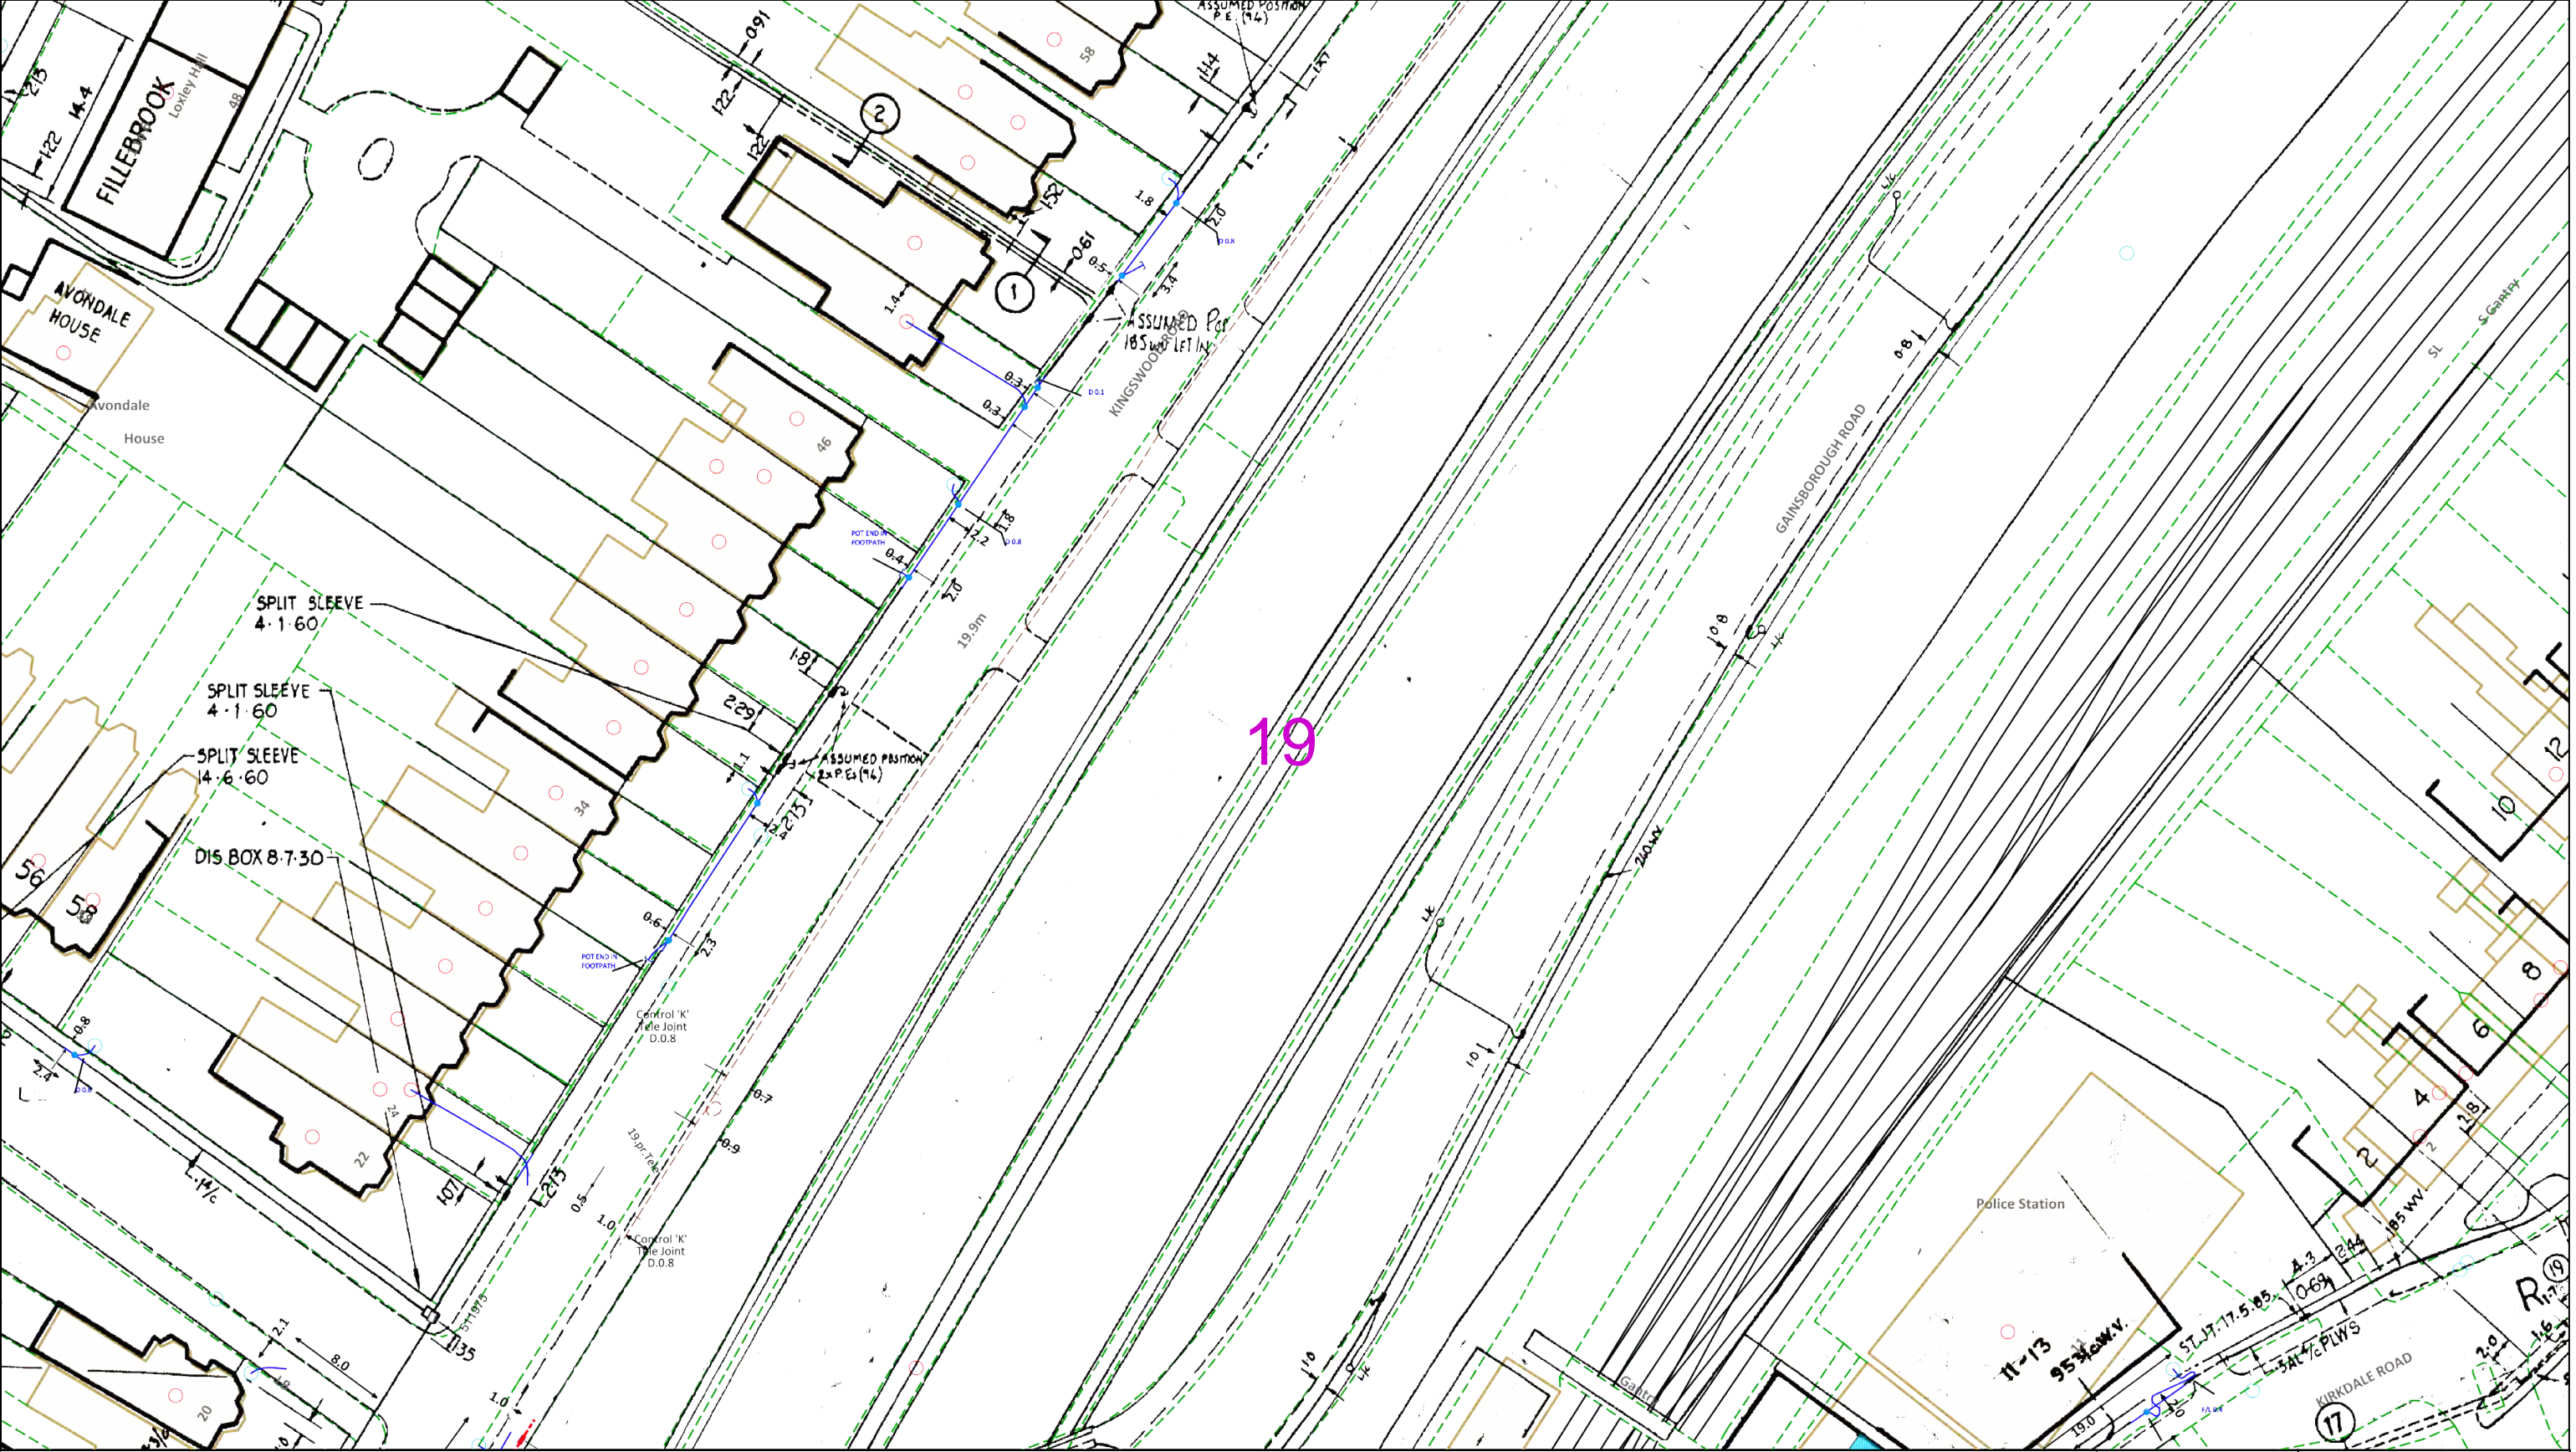

0 25 50

metres

Dig Sites Area: Line:

The quality and accuracy of any print will depend on your printer, your computer and its print settings. Measurements scaled from this plan may not match measurements between the same points on the ground.

<p>This plan must be used with the attached 'Symbols' document.</p>	<p>1. The position of the apparatus shown on this drawing is believed to be correct but the original landmarks may have been altered since the apparatus was installed.</p> <p>2. The exact position of the apparatus should be verified - use approved cable avoidance tools prior to excavation using suitable hand tools.</p> <p>3. It is essential that trial holes are carefully made avoiding the use of mechanical tools or picks until the exact location of all the cables have been determined.</p> <p>4. It must be assumed that there is a service cable into each property, lamp column and street sign, etc.</p> <p>5. All cables must be treated as being live unless proved otherwise by UK Power Networks.</p> <p>6. The information proved must be given to all people working near UK Power Networks plant and equipment. Do not use plans more than 3 months after the issue date for excavation purposes.</p> <p>7. Please be aware that electric cables/lines belonging to other owners of licensed electricity distribution systems may be present and it is your responsibility to identify their location.</p>	<p>1. UK Power Networks does not warrant that the information provided to you is correct. You rely upon it at your own risk.</p> <p>2. UK Power Networks does not exclude or limit its liability if it causes the death of any persons or causes personal injury to a person.</p> <p>3. Subject to paragraph 2 UK Power Networks has no liability to you in contract, in tort (including negligence), for breach of statutory duty or otherwise for any loss, damage, cost, claims, demands, or expenses that you or any third party may suffer or incur as a result of using the information provided whether for physical damage to property or for any economic loss (including without limitation loss of profit, loss of opportunity, loss of savings, loss of goodwill, loss of business, loss of use) or any special or consequential loss or damage whatsoever.</p> <p>4. This plan has been provided to you on the basis of the terms of use set out in the covering letter that accompanies this plan. If you do not accept and/or do not understand the terms of use set out in the covering letter you must not use the plan and must return it to the sender of the letter.</p> <p>5. You are responsible for the security of the information provided to you. It must not be given, sold or made available upon payment of a fee to a third party.</p>
<p>Date Requested: 23/10/2019</p> <p>Job Reference: 16788601</p> <p>Site Location: 538584 187257</p> <p>Requested by: Mr Duncan Phillips</p> <p>Your Scheme/Reference: 7152120</p> <p>Scale: 1:500 (When plotted at A3)</p>		

IF IN DOUBT - ASK! PHONE 0800 056 5866

EMERGENCY - If you damage a cable or line Phone 0800 783 8838 (24hrs) URGENTLY


ALWAYS LOOK UP BEFORE YOU START WORK

Refer to HSE Guidance note GS6

Maps produced at 1:2500 scale are Geo-Schematics which show LV mains cables and overhead lines (in some cases all voltages). Prior to carrying out excavations you must refer to the 1:500 records to determine the location of all known underground plant and equipment.

Reproduced by permission of Ordnance Survey on behalf of HMSO. © Crown copyright and database rights 2019. All rights reserved. Ordnance Survey Licence numbers 100019626, 100019826 and 100019450. Data has been added to the Ordnance Survey base map; all proprietary rights in such additional data are and shall remain the exclusive property of © London Power Networks plc or Eastern Power Networks plc or South Eastern Power Networks plc each being a distribution licensee under section 6(1)(c) of the Electricity Act 1989 for the relevant distribution services area as that term is defined in such licensee's distribution licence. All rights in such data reserved.

Plans generated by DigSAFE Pro™ software provided by LinesearchbeforeUdig.

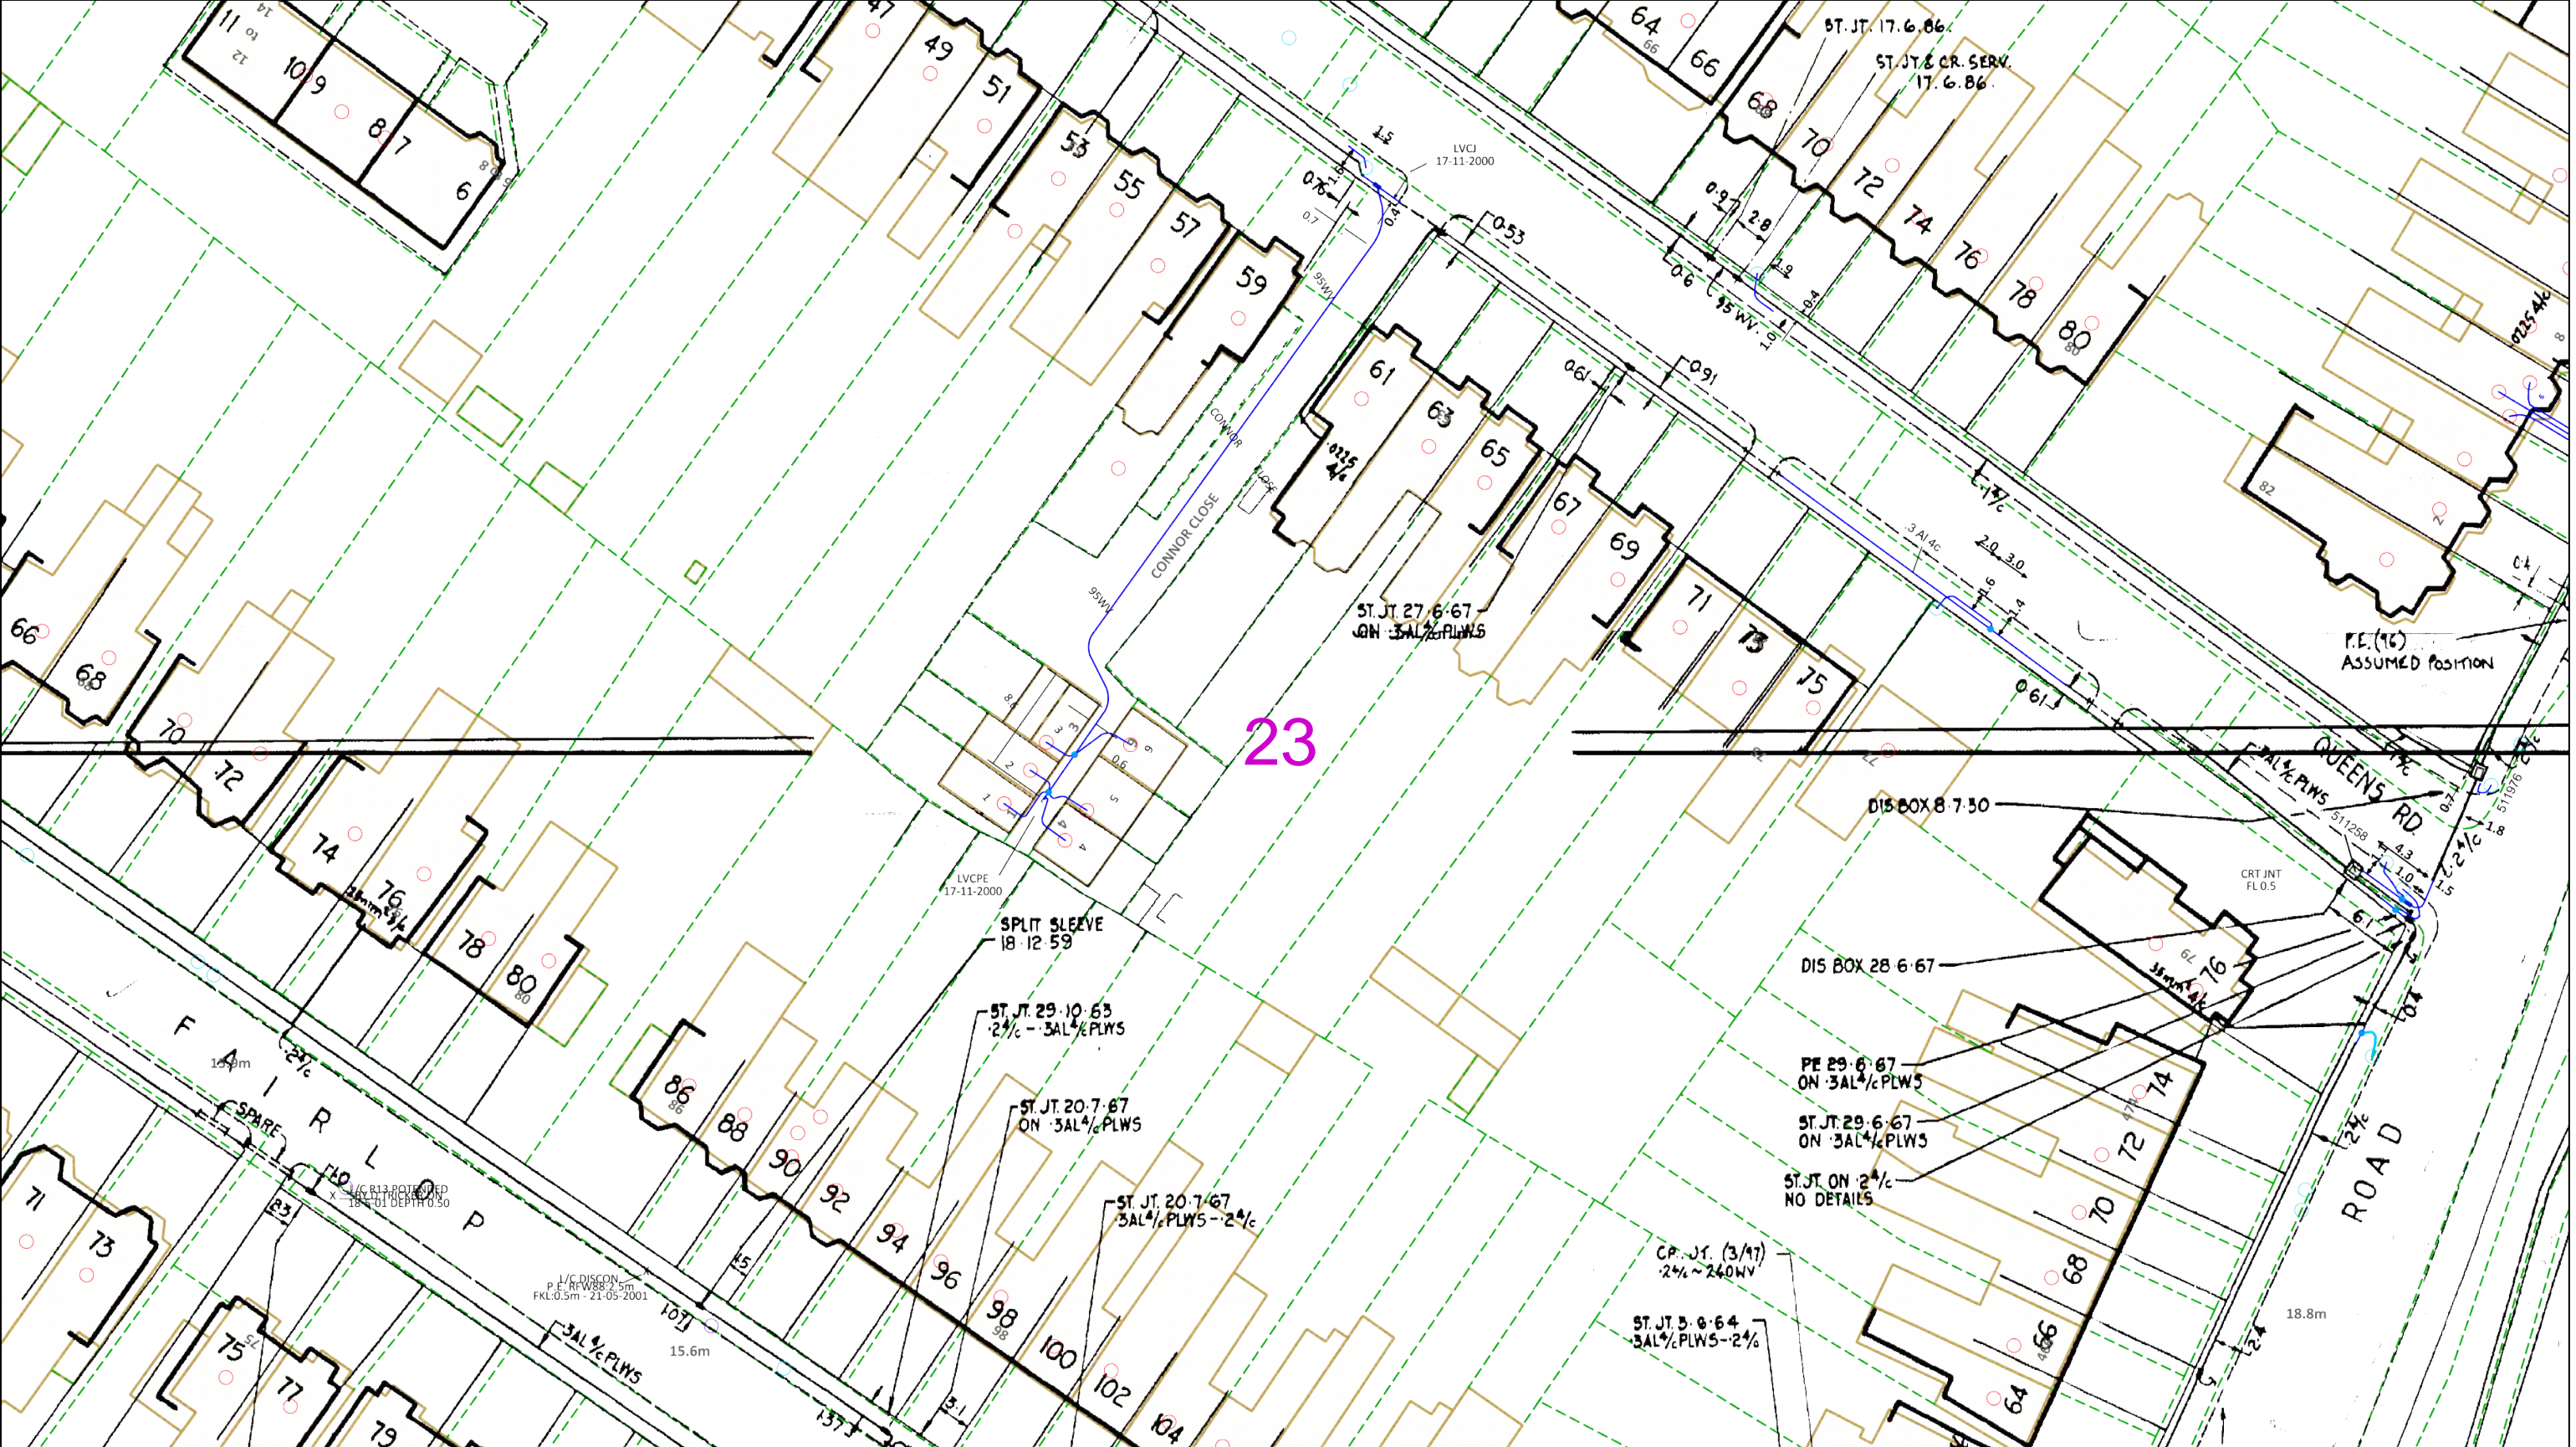

0 25 50

metres

Dig Sites Area: Line:

The quality and accuracy of any print will depend on your printer, your computer and its print settings. Measurements scaled from this plan may not match measurements between the same points on the ground.

This plan must be used with the attached 'Symbols' document.

Date Requested: 23/10/2019
Job Reference: 16788601
Site Location: 538584 187257
Requested by:
Mr Duncan Phillips
Your Scheme/Reference: 7152120

Scale: 1:500 (When plotted at A3)

1. The position of the apparatus shown on this drawing is believed to be correct but the original landmarks may have been altered since the apparatus was installed.

2. The exact position of the apparatus should be verified - use approved cable avoidance tools prior to excavation using suitable hand tools.

3. It is essential that trial holes are carefully made avoiding the use of mechanical tools or picks until the exact location of all the cables have been determined.

4. It must be assumed that there is a service cable into each property, lamp column and street sign, etc.

5. All cables must be treated as being live unless proved otherwise by UK Power Networks.

6. The information proved must be given to all people working near UK Power Networks plant and equipment. Do not use plans more than 3 months after the issue date for excavation purposes.

7. Please be aware that electric cables/lines belonging to other owners of licensed electricity distribution systems may be present and it is your responsibility to identify their location.

1. UK Power Networks does not warrant that the information provided to you is correct. You rely upon it at your own risk.

2. UK Power Networks does not exclude or limit its liability if it causes the death of any persons or causes personal injury to a person.

3. Subject to paragraph 2 UK Power Networks has no liability to you in contract, in tort (including negligence), for breach of statutory duty or otherwise for any loss, damage, cost, claims, demands, or expenses that you or any third party may suffer or incur as a result of using the information provided whether for physical damage to property or for any economic loss (including without limitation loss of profit, loss of opportunity, loss of savings, loss of goodwill, loss of business, loss of use) or any special or consequential loss or damage whatsoever.

4. This plan has been provided to you on the basis of the terms of use set out in the covering letter that accompanies this plan. If you do not accept and/or do not understand the terms of use set out in the covering letter you must not use the plan and must return it to the sender of the letter.

5. You are responsible for the security of the information provided to you. It must not be given, sold or made available upon payment of a fee to a third party.

IF IN DOUBT - ASK!
PHONE 0800 056 5866
EMERGENCY - If you damage a cable or line
Phone 0800 783 8838
(24hrs) URGENTLY

ALWAYS LOOK UP BEFORE YOU START WORK
Refer to HSE
Guidance note GS6

Maps produced at 1:2500 scale are Geo-Schematics which show LV mains cables and overhead lines (in some cases all voltages). Prior to carrying out excavations you must refer to the 1:500 records to determine the location of all known underground plant and equipment.

Reproduced by permission of Ordnance Survey on behalf of HMSO. © Crown copyright and database rights 2019. All rights reserved. Ordnance Survey Licence numbers 100019626, 100019826 and 100019450. Data has been added to the Ordnance Survey base map; all proprietary rights in such additional data are and shall remain the exclusive property of © London Power Networks plc or Eastern Power Networks plc or South Eastern Power Networks plc each being a distribution licensee under section 6(1)(c) of the Electricity Act 1989 for the relevant distribution services area as that term is defined in such licensee's distribution licence. All rights in such data reserved.
Plans generated by DigSAFE Pro™ software provided by LinesearchbeforeUdig.

B5 BT

Maps by email Plant Information Reply



IMPORTANT WARNING

Information regarding the location of BT apparatus is given for your assistance and is intended for general guidance only. No guarantee is given of its accuracy. It should not be relied upon in the event of excavations or other works being made near to BT apparatus which may exist at various depths and may deviate from the marked route.



openreach

CLICK BEFORE YOU DIG

FOR PROFESSIONAL FREE ON SITE ASSISTANCE PRIOR TO COMMENCEMENT OF EXCAVATION WORKS INCLUDING LOCATE AND MARKING SERVICE

email cbyd@openreach.co.uk

ADVANCE NOTICE REQUIRED
(Office hours: Monday - Friday 08.00 to 17.00)
www.openreach.co.uk/cbyd

Accidents happen

If you do damage any Openreach equipment please let us know by calling 0800 023 2023 (opt 1 + opt 1) and we can get it fixed ASAP

KEY TO BT SYMBOLS

	Planned	Live	Change Of State	+	Hatchings	
PCP			Split Coupling		Built	
Pole			Duct Tee		Planned	
Box			Building		Inferred	
Manhole			Kiosk		Duct	
Cabinet			Other proposed plant is shown using dashed lines. BT Symbols not listed above may be disregarded. Existing BT Plant may not be recorded. Information valid at time of preparation. Maps are only valid for 90 days after the date of publication.			
	Pending Add	In Place	Pending Remove	Not In Use		
Power Cable						
Power Duct				N/A		

BT Ref : IPZ01265E

Map Reference : (centre) TQ3905887672


Easting/Northing : (centre) 539058,187672

Issued : 23/10/2019 13:26:45

Reproduced from the Ordnance Survey map by BT by permission of Ordnance Survey on behalf of the Controller of Her Majesty's Stationary Office
(C) Crown Copyright British Telecommunications plc 100028040

WARNING: IF PLANNED WORKS FALL INSIDE HATCHED AREA IT IS ESSENTIAL BEFORE PROCEEDING THAT YOU CONTACT THE NATIONAL NOTICE HANDLING CENTRE. PLEASE SEND E-MAIL TO: nnhc@openreach.co.uk

Maps by email Plant Information Reply

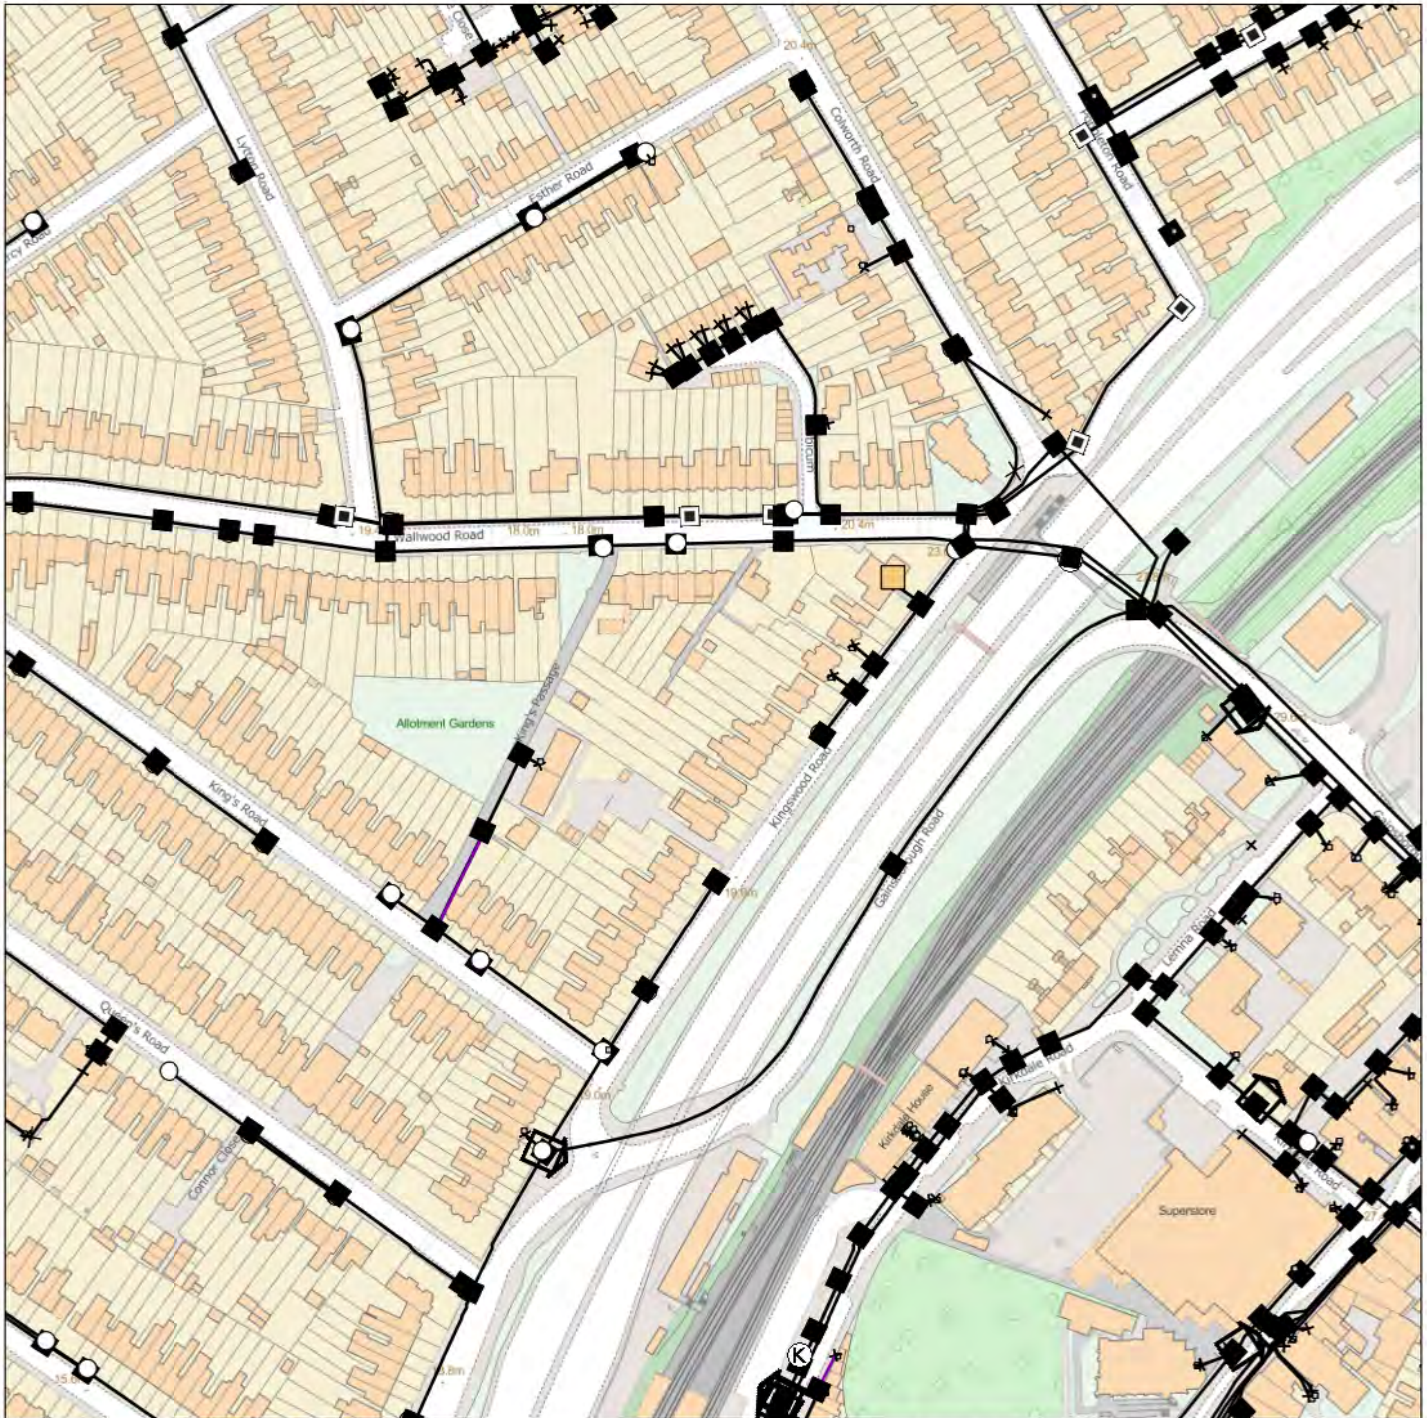

IMPORTANT WARNING

Information regarding the location of BT apparatus is given for your assistance and is intended for general guidance only. No guarantee is given of its accuracy. It should not be relied upon in the event of excavations or other works being made near to BT apparatus which may exist at various depths and may deviate from the marked route.



openreach

CLICK BEFORE YOU DIG

FOR PROFESSIONAL FREE ON SITE ASSISTANCE PRIOR TO COMMENCEMENT OF EXCAVATION WORKS INCLUDING LOCATE AND MARKING SERVICE

email cbyd@openreach.co.uk

ADVANCE NOTICE REQUIRED
(Office hours: Monday - Friday 08.00 to 17.00)
www.openreach.co.uk/cbyd

Accidents happen

If you do damage any Openreach equipment please let us know by calling 0800 023 2023 (opt 1 + opt 1) and we can get it fixed ASAP

KEY TO BT SYMBOLS

	Planned	Live	Change Of State	+	Hatchings	
PCP			Split Coupling		Built	
Pole			Duct Tee		Planned	
Box			Building		Inferred	
Manhole			Kiosk		Duct	
Cabinet			Other proposed plant is shown using dashed lines. BT Symbols not listed above may be disregarded. Existing BT Plant may not be recorded. Information valid at time of preparation. Maps are only valid for 90 days after the date of publication.			
	Pending Add	In Place	Pending Remove	Not In Use		
Power Cable						
Power Duct				N/A		

BT Ref : WKS01265X

Map Reference : (centre) TQ3931387689

Easting/Northing : (centre) 539313,187689

Issued : 23/10/2019 13:27:06

Reproduced from the Ordnance Survey map by BT by permission of Ordnance Survey on behalf of the Controller of Her Majesty's Stationary Office
(C) Crown Copyright British Telecommunications plc 100028040

WARNING: IF PLANNED WORKS FALL INSIDE HATCHED AREA IT IS ESSENTIAL BEFORE PROCEEDING THAT YOU CONTACT THE NATIONAL NOTICE HANDLING CENTRE. PLEASE SEND E-MAIL TO: nnhc@openreach.co.uk

B6 Virgin Media



(c) Crown copyright and database rights 2019 Ordnance Survey 100019209 Date: 24/10/19 Scale: 1:2357 Map Centre: 539165,187670 Data updated: 02/09/19 Telecoms Plan A4

Important Information - please read The purpose of this plan is to identify Virgin Media apparatus. We have tried to make it as accurate as possible but we cannot warrant its accuracy. In addition, we caution that within Virgin Media apparatus there may be instances where mains voltage power cables have been placed inside green, rather than black ducting. Further details can be found using the "Affected Postcodes.pdf", which can be downloaded from this website. Therefore, you must not rely solely on this plan if you are carrying out any excavation or other works in the vicinity of Virgin Media apparatus. The actual position of any underground service must be verified by cable detection equipment, etc. and established on site before any mechanical plant is used. Accordingly, unless it is due to the negligence of Virgin Media, its employees or agents, Virgin Media will not have any liability for any omissions or inaccuracies in the plan or for any loss or damage caused or arising from the use of and/or any reliance on this plan. This plan is produced by Virgin Media Limited (c) Crown copyright and database rights 2019 Ordnance Survey 100019209.

Duct, Trench



Chamber



Cabinet



chilakala.apsar@virginmedia.co.uk

VM.1150367





MLM.

Group

Part of Sweco

T +44 1473 231 100
A North Kiln, Felaw Maltings
46 Felaw Street
Ipswich, IP2 8PN

www.mlmgroupp.com